

**Hampshire County Health Department  
On-Site Sewage Disposal System  
Inspection Form**

Permit # **ST-14-08-119A**

Name of Owner: Negley Rental Porperties Installer: Jason Hott  
 Address: 127 Mercedes Ct., Winchester, Va 22603  
 Property Location: Rt. 29 Lot Size: 1.75AC Acres  
 Type of Facility: Residence Facility is:  New  Existing  
 Design Loading in gpd/# Bedrooms: 3 Source of Water: City

**SEWAGE TANK COMPONENT**

Capacity in Gallons: **1000** Material: precast concrete Pump Chamber 100 Dgal  
 Distances (in feet) of Tank to: Dwelling \_\_\_\_\_  
 Private  Public  Water Source: \_\_\_\_\_ Property Line: 10'

**ON-SITE DISPOSAL SYSTEM**

Class I Systems: Standard Soil Trenches ( ) or Bed ( ) Gravelless Pipe ( ), Diameter \_\_\_ In.  
 Chamber Soil Absorption Trenches ( ) or Bed ( )  
 Class II Systems: Pumped/Dosed Soil Absorption Trenches ( ) or Bed ( ) LPP (X)  
 Evapotranspiration Trenches ( ) or Bed ( )  
 Shallow Soil Absorption Trenches ( ) or Bed ( ) Other: \_\_\_\_\_

No. of Lines: 6 Length (in feet) of Each: 65, 65, 65, 65, 65, 65  
 Width of Trenches: 12 inches/feet Depth to Bottom of Field: 12 inches  
 If Bed, Dimensions (in feet): \_\_\_\_\_ Size Equates to 1875 sq ft of SGF  
 Distance (in feet) of System to: Dwelling \_\_\_\_\_ Private ( ) Public ( )  
 Water Source: \_\_\_\_\_ Property Line: 10'

Remarks: \_\_\_\_\_


GPS: N39 18 35.1 W78 35 51.2

An inspection indicates that  
 The sewage disposal system  
 Described above  
**DOES MEET**   
**DOES NOT MEET**  or  
**CANNOT BE DETERMINED TO**  
**MEET**  the minimum standards  
 Established by the West Virginia  
 Bureau of Public Health.

To correct a health hazard,  
 Modifications to existing systems  
 May be done to improve part of a  
 System. Such modifications may  
 Not be able to be designated as  
 a Does meet system since  
 Inadequate information is known.

Although many factors  
 Contribute to the successful  
 Functioning of a sewage disposal  
 System, this office recommends  
 Water conservation and  
 Maintaining an even usage of  
 Water throughout the week.

Visit Date(s): 12-19-07

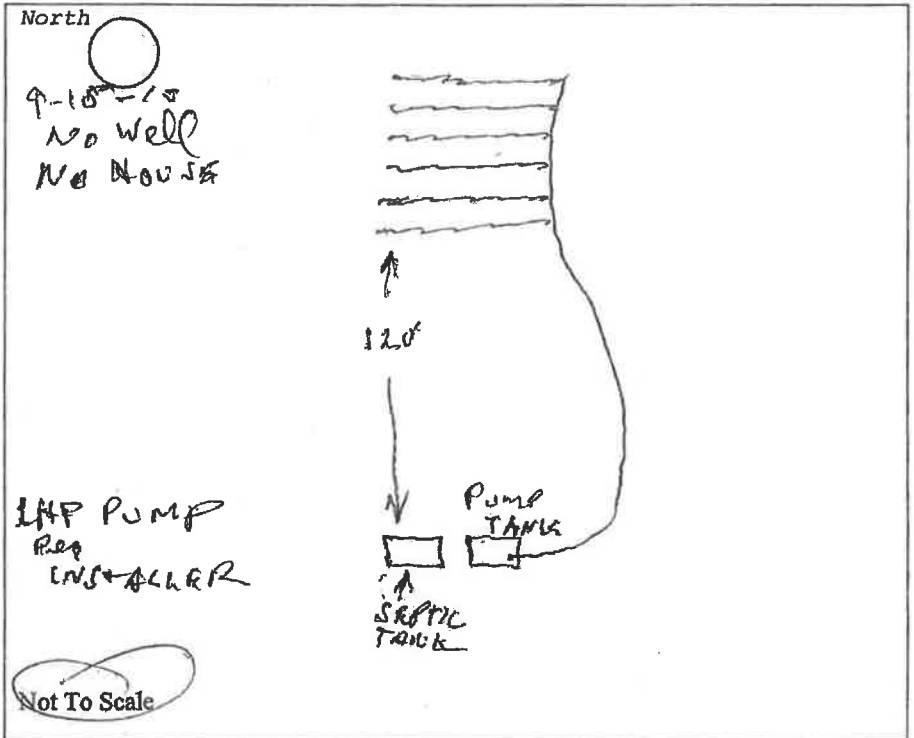

FINAL INSPECTION DATE: 9/15/20:

SANITARIAN: [Signature]



**REPORT SHEET  
FOR  
PERCOLATION AND SIX FOOT HOLE TESTING**

Subdivision Name N/A County Hampshire

Total Number of Lots 1 Name of Applicant Paul Negley

Name of Certified Installer Responsible for Testing Jason Hott

Installer Certification No: 54-05-A-0077 Installer Signature Jason Hott

Address 127 Mercedes Court Winchester, VA  
22603

Type System	Lot Number	Percolation Test Results (Minutes per Inch of Fall)				Average Results	Six Foot Hole Results		Date Conducted
							Depth to Water	Depth to Rock	
IL	N/A	53 min	62 min	41 min	48 min	52	6+	6+	11/6/07

(Attach additional pages if needed)