

WEST VIRGINIA  
SEPTIC TANK INSPECTION FORM

Hampshire County Health Department Installation Permit No. ST 14-85-12

Name of Owner Seymour Ansbard

Address Lot B Buck's Knoll

Property Address Lot # B Buck's Knoll

DESCRIPTION & NUMBER OF UNITS SERVED

Type Facility Served new home No. Water Closets \_\_\_\_\_

Lot Size \_\_\_\_\_ sq. ft. Area suitable for sewage disposal installation \_\_\_\_\_ sq. ft.

Source of Water Supply well No. Lavatories \_\_\_\_\_

No. Bedrooms \_\_\_\_\_ No. Showers or Tubs \_\_\_\_\_ No. Baths \_\_\_\_\_

No. Garbage Grinders no No. Automatic Washers

John

SEPTIC TANK

Material Concrete Length \_\_\_\_\_ x Width \_\_\_\_\_ x Depth \_\_\_\_\_ = \_\_\_\_\_ cubic feet

Liquid Depth \_\_\_\_\_ ft. Liquid Capacity 1000 gal.

Distance to: Dwelling 20 Water Supply 160 Nearest Property Line road  
sh 40-

SOIL ABSORPTION SYSTEM

Type Drain Line Material plastic Trench Width 24 Inches

Trench Depth \_\_\_\_\_ Inches Total Absorption area in Trench Bottom \_\_\_\_\_ sq. ft.

Diameter of Drain Line 4 Inches Type Filter Media gravel (28 in)

No. of Drain Lines 2 Depth Filter Media Under Drain Line 6 Inches

Length of Each Line 80, 50, \_\_\_\_\_, \_\_\_\_\_ ft. Depth Filter Media Over Drain Line 2 in.

Distance of Disposal Field to: (a) Dwelling 136 120 160

(b) Water Supply 176 ft (c) Nearest Property Line road 11  
114

An inspection of the septic tank system described herein disclosed that said system (MEETS, DOES NOT MEET) the minimum standards established by the West Virginia State Department of Health.


8/31/84  
Date

[Signature]  
Sanitarian

SKETCH OF SYSTEM TO BE DRAWN ON BACK

Note: Copy of this inspection report must be given to owner and the original filed in the Health Department files. PERMANENT RECORD - DO NOT DESTROY.

36  
- 30 -

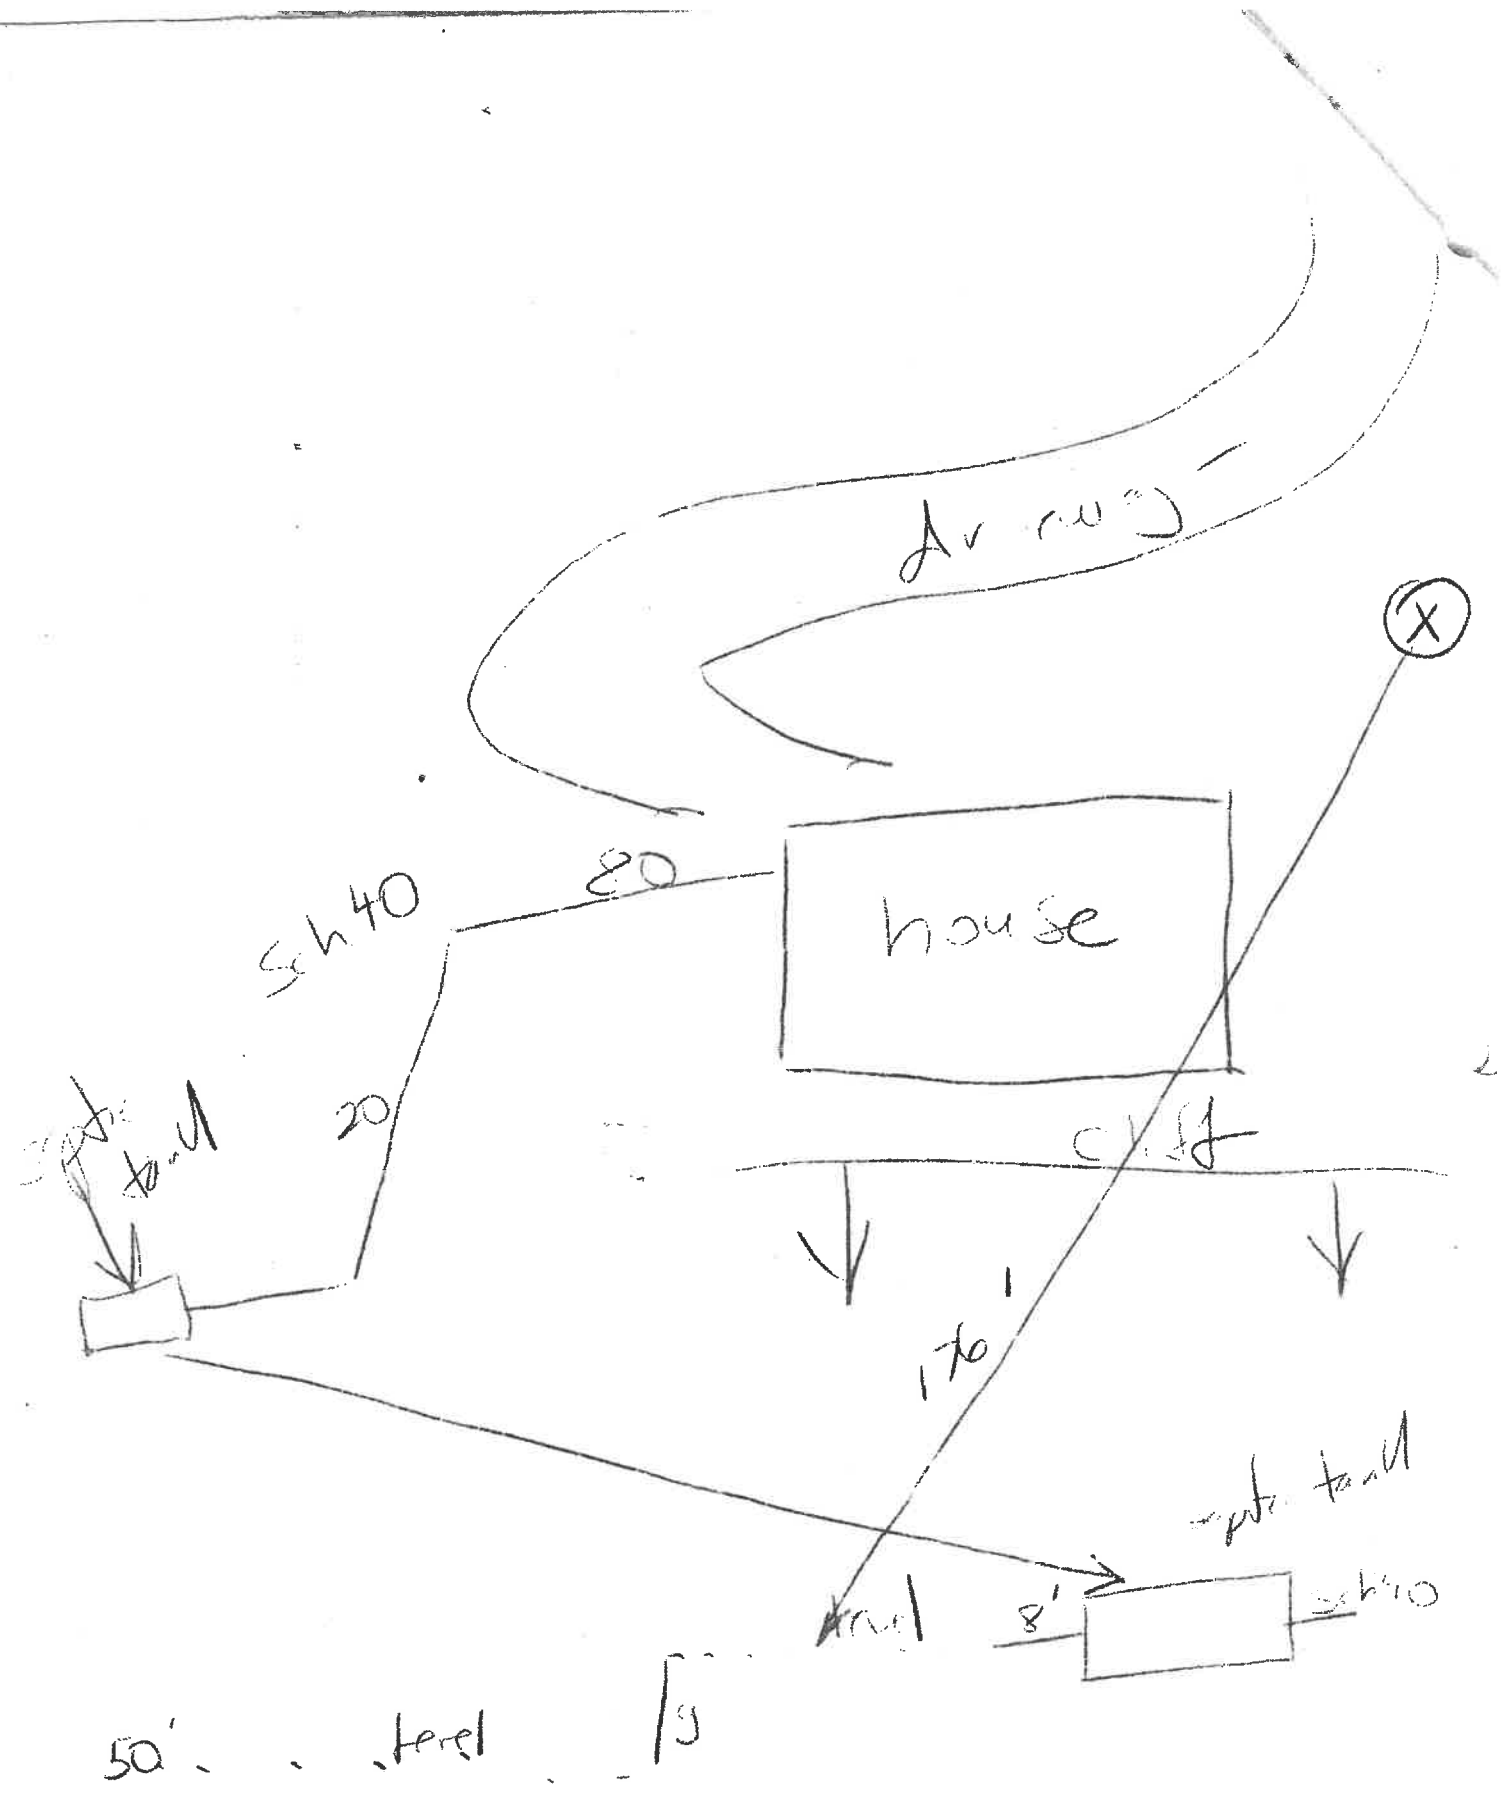

↓ slope

David Dunlop  
Sanitarian