

WEST VIRGINIA
SEPTIC TANK INSPECTION FORM

Hampshire County Health Department Installation Permit No. ST-14-93-404
Name of Owner Edwin Cudamin
Address 3805 Everett St., Baltimore, MO
Property Address Woodland Estates Lot #24

DESCRIPTION & NUMBER OF UNITS SERVED

Type Facility Served trailer No. Water Closets
Lot Size 5 acres sq. ft. Area suitable for sewage disposal installation sq. ft.
Source of Water Supply well No. Lavatories
No. Bedrooms 3 No. Showers or Tubs No. Baths
No. Garbage Grinders 0 No. Automatic Washers 1

SEPTIC TANK

Material pumex Length x Width x Depth = cubic feet
Liquid Depth ft. Liquid Capacity 1000 gal.
Distance to: Dwelling 12' Water Supply 110' Nearest Property Line 80'

SOIL ABSORPTION SYSTEM

Type Drain Line Material gravel Trench Width 24 Inches
Trench Depth 36-24 Inches Total Absorption area in Trench Bottom 560 sq. ft.
Diameter of Drain Line 10 Inches Type Filter Media
No. of Drain Lines 4 Depth Filter Media Under Drain Line Inches
Length of Each Line 80, 80, 80, 40 ft. Depth Filter Media Over Drain Line in.
Distance of Disposal Field to: (a) Dwelling 20'
(b) Water Supply 110' (c) Nearest Property Line 10'

An inspection of the septic tank system described herein disclosed that said system (MEETS, DOES NOT MEET) the minimum standards established by the West Virginia State Department of Health.

6-30-83
Date


[Signature]
Sanitarian

SKETCH OF SYSTEM TO BE DRAWN ON BACK


Note: Copy of this inspection report must be given to owner and the original filed in the Health Department files. PERMANENT RECORD - DO NOT DESTROY.

road

10' ②

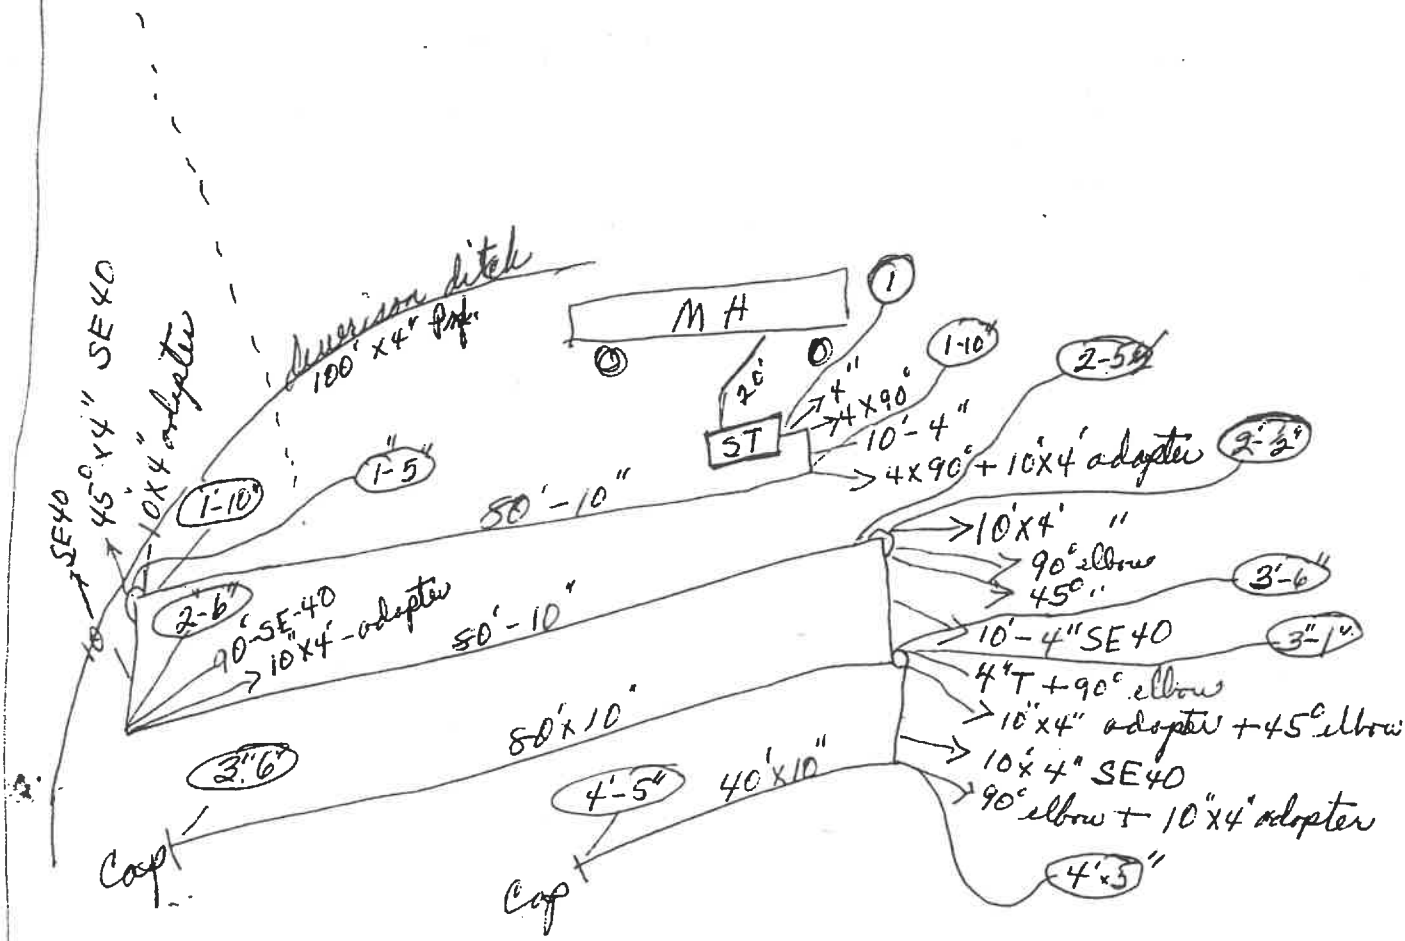

Shank
David

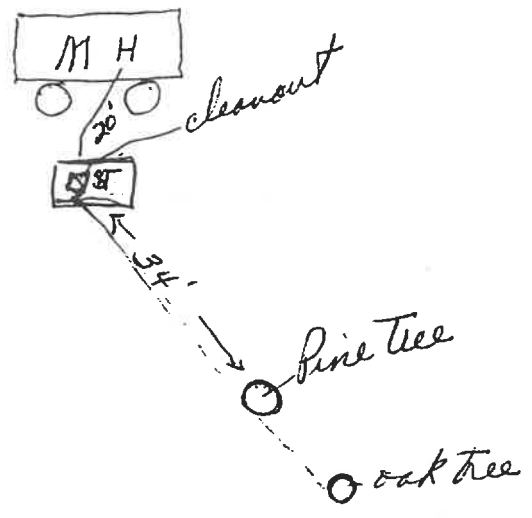

Date(s) 11/16/93 County Hampshire Permit #: DW-14-06-93-258
Town: AUGUSTA Area Name/Location Woodland Est. Lot 24
Well Owner: Edwin S. Cudanian Address: 3805 Everett St.
Telephone Number: 410-354-1972 Baltimore Md. 21225
Well Driller: B. Mark Smith Address: HC 86 Box 2-A
Telephone Number: 304-822-4786 Springfield WV 26763
Well Log: 304-822-5867

DEPTH IN FEET	FORMATIONS: KIND, THICKNESS, AND IF WATER BEARING	REMARKS:
0-25	Shale	Type of Well: <u>home</u> Drilling Method: <u>Air-Hammer</u>
26-224	hard red Sandrock	Well Diameter: <u>6"</u> Casing O.D.: <u>6 5/8"</u>
225	Water	Well Depth: <u>410</u> Date Completed: <u>11/16/93</u>
226-403	hard red Sandrock	CASING: Length <u>42</u> Feet Height above ground <u>1</u> Feet
404	water	<input checked="" type="checkbox"/> Steel <input type="checkbox"/> Plastic <input type="checkbox"/> Cast Iron
405-410	hard red Sandrock	Other _____ Type _____
		SCREEN
		<input checked="" type="checkbox"/> None Installed
		Type _____ Diameter _____
		Slot/Gauge _____ Length _____
		Set Between _____ Ft. and _____ Ft.
	1500 Gph.	

DETAILS	#1	#2	#3
Static Water Level (Ft. Below Grade)	130		
Pumping Rate (GPM)	25		
Pumping Level (Ft Below Grade)	380		
Duration of Test (In Hours)	1		
Recovery Time to Static Level (In Hours)	1		

Pitless Adapter: Type, Make, Etc. _____

Well Cap: Type, Make, Etc. Standard

Well Seal: Type, Make, Etc. _____

Well Platform: _____

Length _____ Width _____ Thickness _____

Grouting: ☒ Yes ☐ No

All Public Water Supplies must be grouted.

B. Mark Smith #001
Name B.W. Smith Well Drilling Certification No.
Registered Business Name Benjamin Mark Smith 11/16/93
Signed Date

WEST VIRGINIA
SEPTIC TANK INSPECTION FORM

Namphshire County Health Department Installation Permit No. ST-14-97-230
Name of Owner Ruby Hagan
Address P.O. Box 786, Augusta, WV
Property Address Woodland Estates Lot #26

DESCRIPTION & NUMBER OF UNITS SERVED

Type Facility Served house No. Water Closets
Lot Size 2.14 ^{acres} sq. ft. Area suitable for sewage disposal installation sq. ft.
Source of Water Supply well No. Lavatories
No. Bedrooms 3 No. Showers or Tubs No. Baths
No. Garbage Grinders 0 No. Automatic Washers yes

SEPTIC TANK

Material precast concrete Length x Width x Depth = cubic feet
Liquid Depth ft. Liquid Capacity 1000 gal.
Distance to: Dwelling 22' Water Supply 122' Nearest Property Line 60'

SOIL ABSORPTION SYSTEM

Type Drain Line Material gravel/hoax Trench Width 24-27 Inches
Trench Depth 24-30 Inches Total Absorption area in Trench Bottom 900 sq. ft.
Diameter of Drain Line 10 Inches Type Filter Media
No. of Drain Lines 3 Depth Filter Media Under Drain Line Inches
Length of Each Line 100, 100, 100, ft. Depth Filter Media Over Drain Line in.
Distance of Disposal Field to: (a) Dwelling 21'
(b) Water Supply 132' (c) Nearest Property Line 60'

An inspection of the septic tank system described herein disclosed that said system (MEETS, DOES NOT MEET) the minimum standards established by the West Virginia State Department of Health.

Date

Sanitarian

SKETCH OF SYSTEM TO BE DRAWN ON BACK

Note: Copy of this inspection report must be given to owner and the original filed in the Health Department files. PERMANENT RECORD - DO NOT DESTROY.

⊗

HOUSE

sch 40
22 FT

sch 40
10 FT

sch 40
26 FT

sch 40
10 FT

sch 40
22 FT
sch 40
26 FT

sch 40
22 FT
sch 40
26 FT

sch 40
22 FT

sch 40
22 FT

sch 40
22 FT

WV STATE DEPARTMENT OF HEALTH
Office of Environmental Health Services
ENVIRONMENTAL ENGINEERING DIVISION

SW258

*Rec'd
9-6-89*

WELL COMPLETION REPORT

Date(s) Aug 15, 1989 County Hampshire Permit #: DW-14-08-90-38
Town: Augusta Area Name/Location Woodland Estate Lot #26
Well Owner: Thomas Jordan Address: 2821 Plainfield Rd.
Telephone Number: (301) 282-0044 Baltimore, MD 21222
Well Driller: Serry W Adams Address: P.O. Box 73
Telephone Number: (304) 298-3280 Fort Ashby, WV 26719

WELL LOG

DEPTH IN FEET	FORMATIONS: KIND, THICKNESS, AND IF WATER BEARING	REMARKS:
0-6	Yellow Clay - Unconsolidated	Type of Well: <u>D/W</u> Drilling Method: <u>Air Rotary/Hanna</u>
7'	Red Clay & Shale - Unconsolidated	Casing O.D.: <u>6-5/8"</u>
14'	Brown Dirt - Unconsolidated	Well Depth: <u>140'</u> Date Completed: <u>Aug 15, 1989</u>
16'	Red Shale - Consolidated	CASING: Length <u>30</u> Feet Height above ground <u>1</u> Feet
29'	Red Shale - Consolidated	<input checked="" type="checkbox"/> Steel <u>GALV</u> <input type="checkbox"/> Plastic <input type="checkbox"/> Cast Iron
	Cement & Set Casing	Other _____ Type _____
40'	Red Shale - Consolidated	
40-43'	Red Shale - Water 1 GPM	SCREEN
96'	Red Shale - Water 2 GPM	<input checked="" type="checkbox"/> None Installed
114'	Gray Shale - Consolidated	Type _____ Diameter _____
127'	Red Shale - Water 5 GPM	Slot/Gauge _____ Length _____
140'	Red Shale - Consolidated	Set Between _____ Ft. and _____ Ft.
Stopped Drilling Operation		

PUMPING OR BAILING TEST

DETAILS	#1	#2	#3
Static Water Level (Ft. Below Grade)	<u>25</u>		
Pumping Rate (GPM)	<u>8</u>		
Pumping Level (Ft. Below Grade)	<u>130</u>		
Duration of Test (In Hours)	<u>1</u>		
Recovery Time to Static Level (In Hours)	<u>1</u>		

WELL HEAD

Pitless Adapter: Type, Make, Etc. Dicken LDS-10 BRASS - Type
Well Cap: Type, Make, Etc. Payer 6-5/8" Conduit - Type
Well Seal: Type, Make, Etc. _____
Well Platform: To be installed by owner
Length _____ Width _____ Thickness _____
Grouting: ☐ Yes ☒ No
All Public Water Supplies must be grouted.

I hereby certify that this well was drilled and constructed under my supervision, in compliance with all requirements of the referenced permit, and that this record is true to the best of my knowledge and belief.

Serry W Adams 004
Name _____ Certification No. _____
A & S Pump Co.
Registered Business Name _____
Serry W Adams Aug 15, 1989
Signed _____ Date _____