

WEST VIRGINIA
SEPTIC TANK INSPECTION FORM

Bloomery

Hampshire County Health Department Installation Permit No. ST-14-76-214

Name of Owner DRENNER, DEWEY

Address 352 FERDINAND MARYLAND 21061

Property Address SPRINGFIELD GAP MT. SUB-DIVISION, LOT 6, SECTION

DESCRIPTION & NUMBER OF UNITS SERVED

Type Facility Served NEW HOUSE No. Water Closets 2

Lot Size 6.8-ACRES sq. ft. Area suitable for sewage disposal installation 10,000 sq. ft.

Source of Water Supply DRILLED WELL No. Lavatories 2

No. Bedrooms 2 No. Showers or Tubs 1 No. Baths 1 1/2

No. Garbage Grinders 0 No. Automatic Washers 1

SEPTIC TANK

Material CONCRETE Length _____ x Width _____ x Depth _____ = _____ cubic feet

Liquid Depth _____ ft. Liquid Capacity 1,000 gal.

Distance to: Dwelling 60' Water Supply 120' Nearest Property Line 150'

SOIL ABSORPTION SYSTEM

Type Drain Line Material PLASTIC Trench Width 24 Inches

Trench Depth 30 Inches Total Absorption area in Trench Bottom 420 sq. ft.

Diameter of Drain Line 4 Inches Type Filter Media GRAVEL

No. of Drain Lines 3 Depth Filter Media Under Drain Line 6 Inches

Length of Each Line 70', 70', 70' ft. Depth Filter Media Over Drain Line 2 in.

Distance of Disposal Field to: (a) Dwelling 80'

(b) Water Supply 140' (c) Nearest Property Line 50'

An inspection of the septic tank system described herein disclosed that said system (MEETS, ~~DOES NOT MEET~~) the minimum standards established by the West Virginia State Department of Health.


APRIL 7, 1977
Date

Sanitarian

SKETCH OF SYSTEM TO BE DRAWN ON BACK

Note: Copy of this inspection report must be given to owner and the original filed in the Health Department files. PERMANENT RECORD - DO NOT DESTROY.

WEST

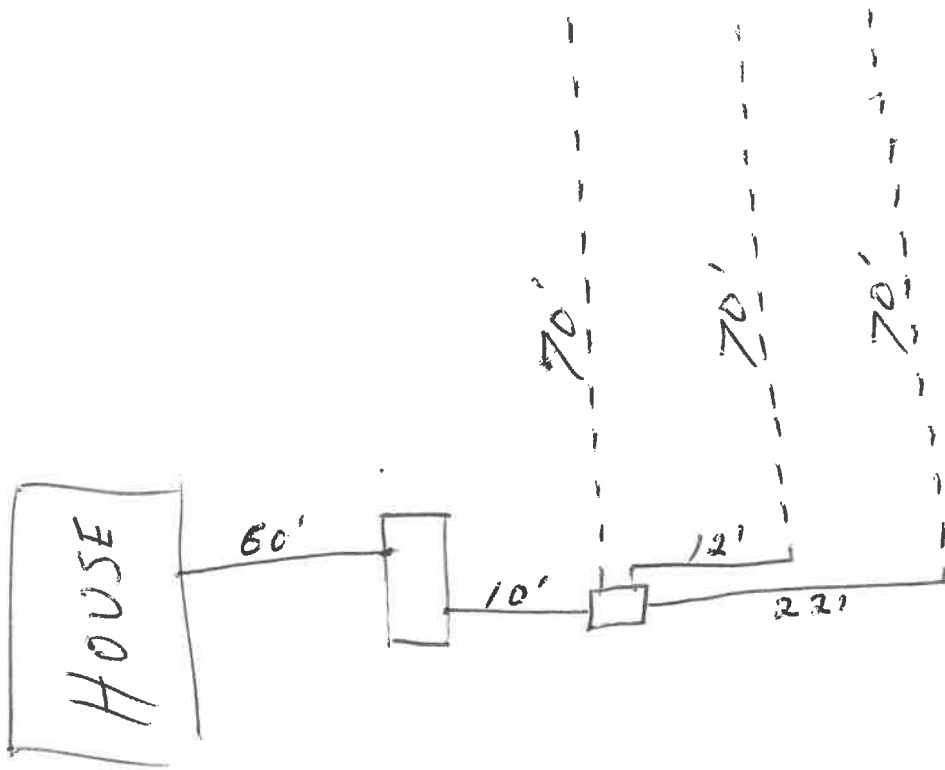

DRIVEWAY