

WEST VIRGINIA  
SEPTIC TANK INSPECTION FORM

Hampshire County Health Department Installation Permit No. ST-14-91-572

Name of Owner Arthur Keenan

Address RR 1 Box 103 Paw Paw WV

Property Address East side of Rt. 29, 1 mile from Pin Oak Farm

DESCRIPTION & NUMBER OF UNITS SERVED

Type Facility Served mobile home No. Water Closets 1

Lot Size 1 acre sq. ft. Area suitable for sewage disposal installation 1/2 acre sq. ft.

Source of Water Supply well No. Lavatories 1

No. Bedrooms 2 No. Showers or Tubs 1 No. Baths 1

No. Garbage Grinders — No. Automatic Washers —

SEPTIC TANK

Material concrete Length 8' x Width 5.5' x Depth 5' = 220 cubic feet

Liquid Depth 4' ft. Liquid Capacity 1000 gal.

Distance to: Dwelling 20' Water Supply 80' Nearest Property Line 60'

SOIL ABSORPTION SYSTEM

Type Drain Line Material gravelless Trench Width 24 Inches

Trench Depth 24 Inches Total Absorption area in Trench Bottom 580 sq. ft.

Diameter of Drain Line 8 Inches Type Filter Media —

No. of Drain Lines 3 Depth Filter Media Under Drain Line — Inches

Length of Each Line 90, 100, 100, ft. Depth Filter Media Over Drain Line — in

Distance of Disposal Field to: (a) Dwelling 50'

(b) Water Supply 100' (c) Nearest Property Line 20'


An inspection of the septic tank system described herein disclosed that said system (MEETS) DOES NOT MEET the minimum standards established by the West Virginia State Department of Health.

7-8-91  
Date

Lee O'Hara  
Sanitarian

SKETCH OF SYSTEM TO BE DRAWN ON BACK

Note: Copy of this inspection report must be given to owner and the original filed in the Health Department files. PERMANENT RECORD - DO NOT DESTROY.

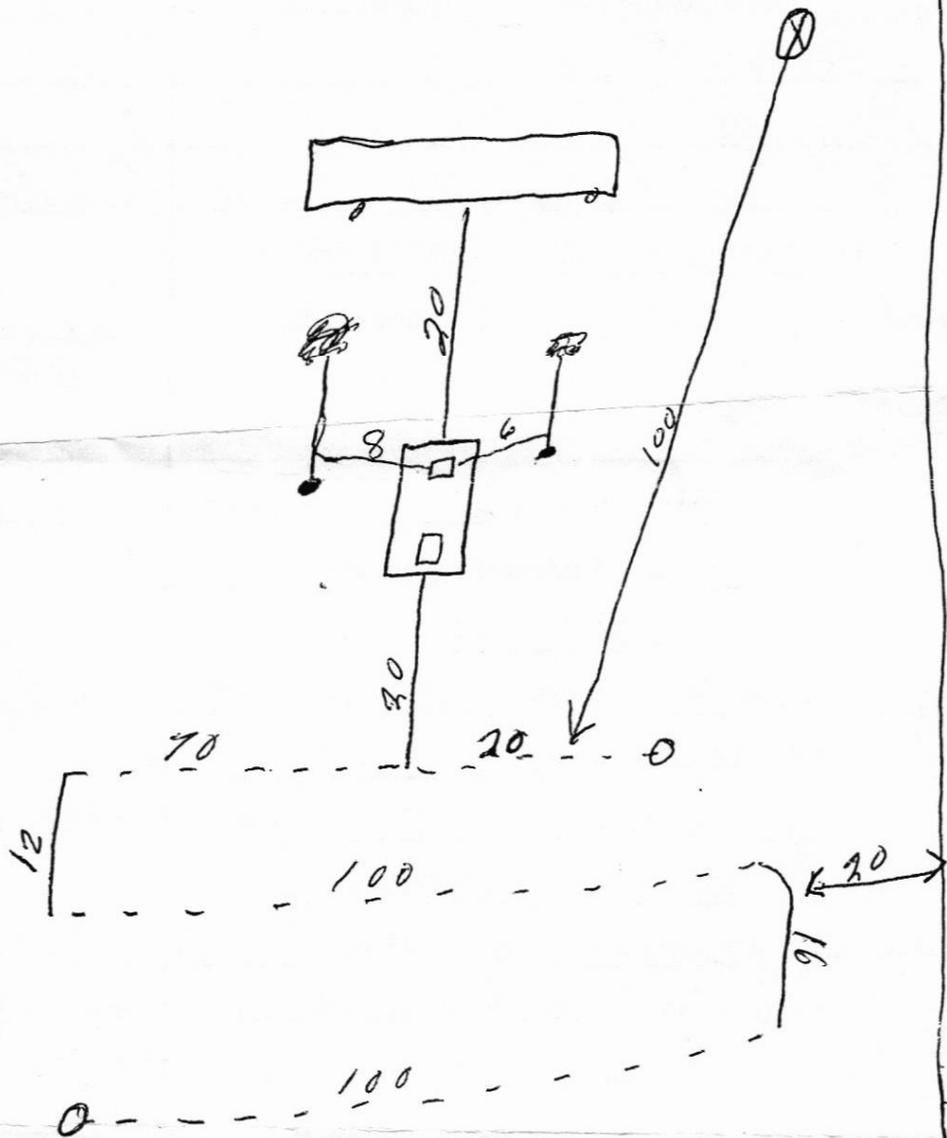

To: Arthur D. Kerns Address: RR1, Box 103 Paw Paw WV  
25434

You are hereby issued a permit to install  
a small sewage disposal system consisting of a septic tank and drainfield  
and located at E side of Rt. 29, 1 mile from Pit Oak Fountain.


This small sewage disposal system shall meet the following specifications:

1. Septic Tank
  - a. Shall be made of porcud concrete and not less than 1000 gallon capacity.
2. Soil-Absorption System
  - a. Shall consist of 3 distribution lines 4" in diameter.
  - b. Each distribution line shall be 85 85 85 feet in length
  - c. Each trench shall be 24 inch width with ZERO slope on trench bottom and ZERO slope on each distribution line.
  - d. No trench shall be more than 24 inches deep. 10" gravelless
  - e. Total soil-absorption area in trench bottoms shall be 765 sq. ft.
  - f. Filter material shall be gravel and not greater than 1/2 - 2 1/2 inches in diameter.
  - g. Filter material under each line shall be not less than 1/4 inches deep and not less than 2 inches over each distribution line.
  - h. Filter material shall be covered with gravel prior to backfilling.
  - i. Trenches shall be backfilled at least 6" above ground surface to provide for settling of backfill.
3. Other Small Sewage or Excreta Disposal Systems (Name the type system to be used, then use back of sheet to describe the details of the system.)  
None unless problems encountered at construction.
4. Special Requirements
  - a. Small sewage and excreta disposal systems shall be located at least 10 ft. from any property line and a minimum of 20 ft. from any stream or roadside cut.
  - b. Septic tanks shall be located at least 10 ft. and excreta disposal systems a minimum of 20 ft. from building foundation.
  - c. Septic tanks shall be located a minimum of 50 ft. and soil-absorption systems and excreta disposal systems a minimum of 100 ft. from any ground water supply or cistern.
5. This permit is not transferable and automatically expires 6 months after date of issue.
6. The applicant or his agent must notify this department, phone 822-5111 at least 72 hours before the system is ready for inspection.
7. All small sewage and excreta disposal systems must be inspected and approved prior to being covered with earth or otherwise put into service. Any applicable system or part thereof covered before being inspected shall be uncovered at the direction of the SANITARIAN.
8. This permit is NULL AND VOID when official inspection reveals conditions are different than those stipulated in this permit or if facts later become known that a health hazard would result by the installation of this system.

5-16-91  
Date of Issue  
Hampshire County Health Department  
66 North High Street  
Romney, West Virginia  
Health Department


Lee O'Hara  
Name  
Sanitarian  
Title

Rit 29

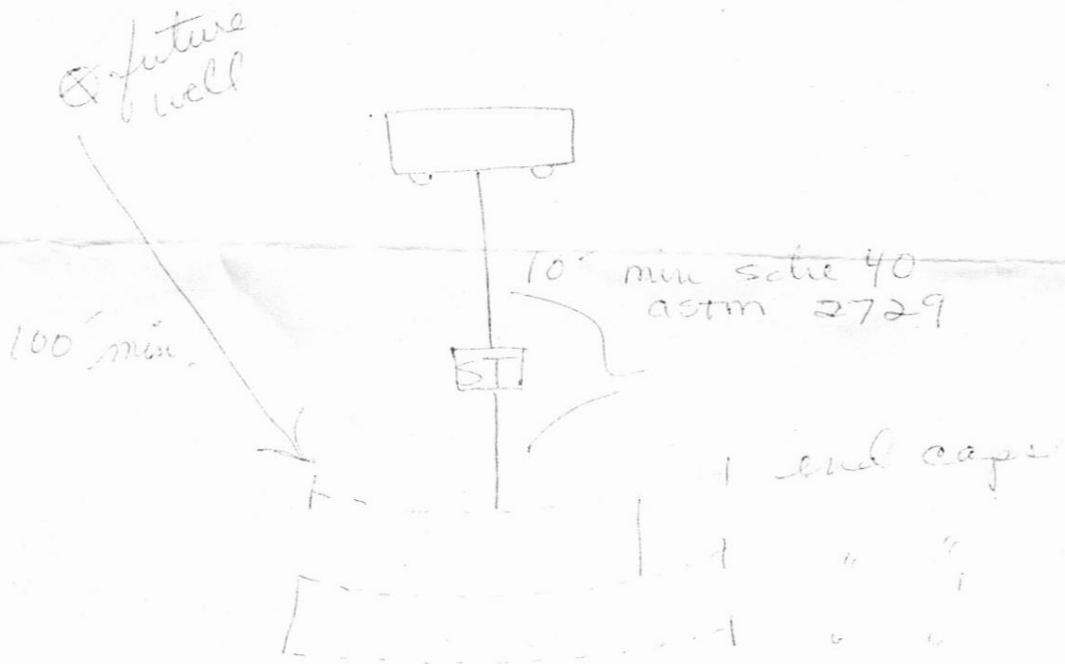

Note: Trees are not to be removed from septic field area.

Rt 29

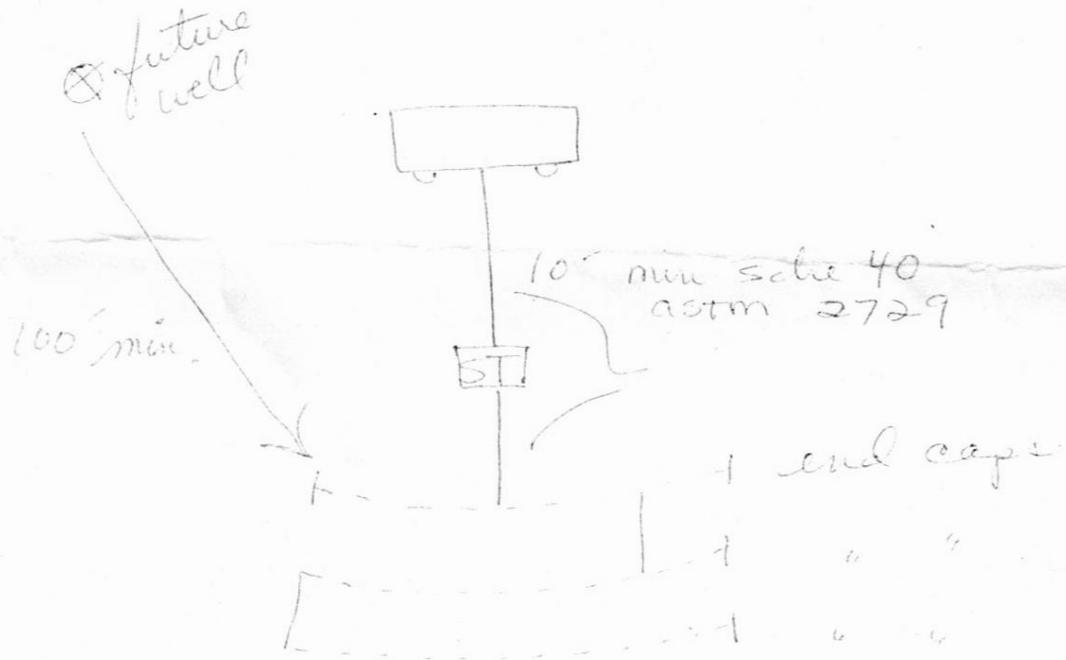

Note: Trees are not to be removed from septic field area.

local home owner