

STATE OF WEST VIRGINIA

Permit No.: ST-16-04-128

INSPECTION TO BE PRINTED OR TYPED

HARDY COUNTY HEALTH DEPARTMENT

Tax Map: \_\_\_\_\_ Parcel #: \_\_\_\_\_

ON-SITE SEWAGE DISPOSAL SYSTEM INSPECTION FORM

County Road: \_\_\_\_\_

County: Hardy

Name of Owner: Victor G. Shockey Installer: Scott Sec

Address: 325 Tanglewood Drive, Moorefield WV 26836

Property Location: Lot 24 B Tanglewood Subdivision

Type of Facility: Home Facility is: New ( ) Existing (X) Lot Size: \_\_\_\_\_ Sq. Ft./Acres

Design Loading in gpd/No. Bedrooms: \_\_\_\_\_ Source of Water Supply: \_\_\_\_\_

SEWAGE TANK COMPONENT

Capacity in Gallons: \_\_\_\_\_ Material: \_\_\_\_\_ Manufacturer: \_\_\_\_\_

Distance (in feet) of Tank to: Dwelling: \_\_\_\_\_ Private ( )/Public ( ) Water Source: \_\_\_\_\_ Property Line: \_\_\_\_\_

ON-SITE DISPOSAL SYSTEM

Class I Systems: Standard Soil Absorption Trenches ( ) or Bed ( ) Gravelless Pipe ( ), Diameter: \_\_\_\_\_ Inches  
 Chamber Soil Absorption Trenches ( ) or Bed ( )

Class II Systems: Pumped/Dosed Soil Absorption Trenches ( ) or Bed ( ) Evapotranspiration Trenches ( ) or Bed ( )  
 Shallow Soil Absorption Trenches ( ) or Bed ( ) Other: \_\_\_\_\_

No of Lines: 2 Length (in feet) of Each: 60, 60

Width of Trenches: 18-36 inches/feet Depth to Bottom of Field: 18-36 inches

If Bed, Dimensions (in Feet): \_\_\_\_\_ If Chamber System, Name: Infiltrator, No. of Units: 30

Approved and Adequate Materials Used? Yes (X) No ( ) Size Equates to: 600 Square Feet of Standard Gravel Field.

Distance (in feet) of System to: Dwelling: \_\_\_\_\_ Private ( )/Public ( ) Water Source: \_\_\_\_\_ Property Line: \_\_\_\_\_


Remarks: \_\_\_\_\_

An inspection indicates that the sewage disposal system described above **DOES MEET (X)**, **DOES NOT MEET ( )**, **CANNOT BE DETERMINED TO MEET ( )** the minimum standards established by the West Virginia Bureau of Public Health.

To correct a health hazard, modifications to existing systems may be done to improve part of a system. Such modifications may not be able to be designated as a **does meet** system since inadequate information is known.

Although many factors contribute to the successful functioning of a sewage disposal system, this office recommends water conservation and maintaining an even usage of water throughout the week.

Sketch of Installation with Triangulation or Distance to Specific Landmarks:

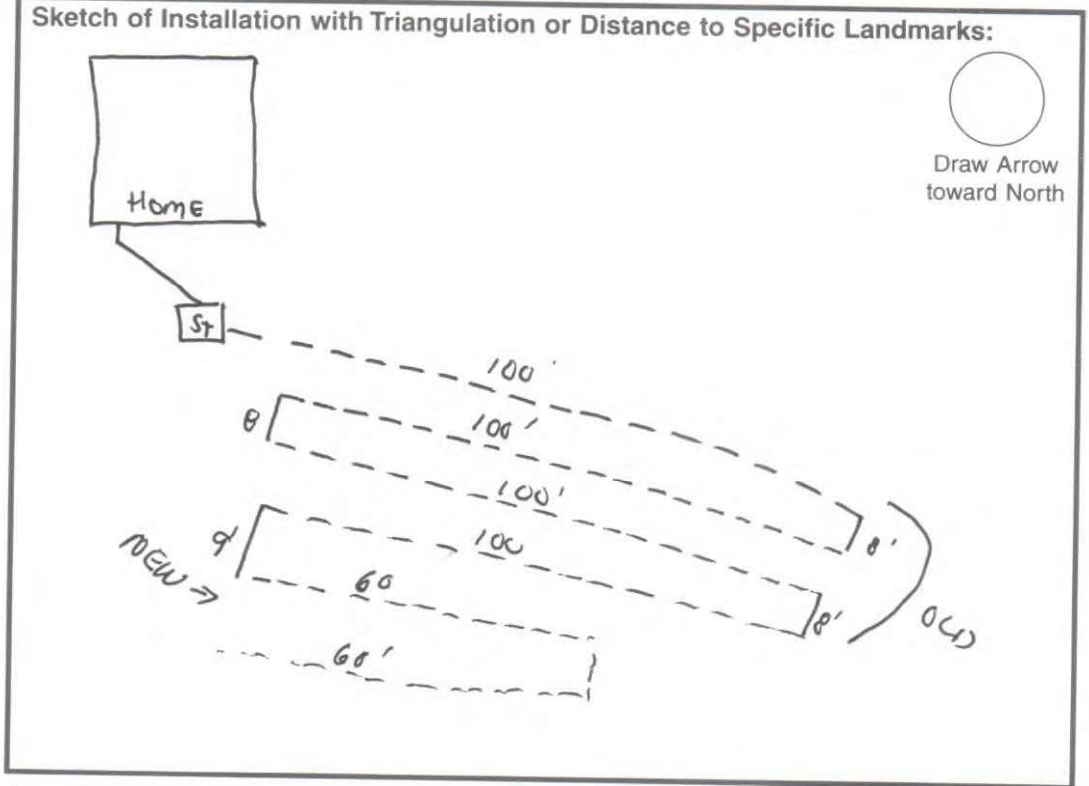

Visit Date(s) June 9, 2004

Final Inspection Date: June 11, 04

Sanitarian: Will Ows, Santa