

INSPECTION TO BE PRINTED OR TYPED

HEALTH DEPARTMENT

Permit No.: ST-14-03-249

Tax Map: 25 Parcel #: 003

County Road: _____

County: NAMPSHIRE

ON-SITE SEWAGE DISPOSAL SYSTEM INSPECTION FORM

Name of Owner: Robert B. Bunch / Marilyn Burkett Installer: Rick Kauter
Address: 1011 SHARON DRIVE GREEN BURNIE MD 21061
Property Location: APPLE FIELDS NOT A 28
Type of Facility: HOUSE Facility is: New Existing () Lot Size: 2.6 Sq. Ft. (Acres)
Design Loading in gpd/No. Bedrooms: 3 BR Source of Water Supply: CISTERN

SEWAGE TANK COMPONENT

Capacity in Gallons: 1000 Material: CONCRETE Manufacturer: JOLD
Distances (in feet) of Tank to: Dwelling: 17 Private ()/Public () Water Source: WELL Property Line: 10'
to be

ON-SITE DISPOSAL SYSTEM

Class I Systems: Standard Soil Absorption Trenches () or Bed () Gravelless Pipe (), Diameter: _____ Inches
Chamber Soil Absorption Trenches (X) or Bed ()
Class II Systems: Pumped/Dosed Soil Absorption Trenches () or Bed () Evapotranspiration Trenches () or Bed ()
Shallow Soil Absorption Trenches () or Bed () Other: _____

No. of Lines: 2 Length (in feet) of Each: 90, 90
Width of Trenches: 30 inches/feet Depth to Bottom of Field: 24-36 inches
If Bed, Dimensions (in Feet): _____ If Chamber System, Name: INFILTRATOR No. of Units: 30
Approved and Adequate Materials Used? Yes No () Size Equates to: 90 Square Feet of Standard Gravel Field
Distances (in feet) of System to: Dwelling: 55' Private ()/Public () Water Source: WELL Property Line: 10'
to be



Remarks: _____

An inspection indicates that the sewage disposal system described above **DOES MEET (X)**, **DOES NOT MEET ()**, **CANNOT BE DETERMINED TO MEET ()** the minimum standards established by the West Virginia Bureau of Public Health.

To correct a health hazard, modifications to existing systems may be done to improve part of a system. Such modifications may not be able to be designated as a **does meet** system since inadequate information is known.

Although many factors contribute to the successful functioning of a sewage disposal system, this office recommends water conservation and maintaining an even usage of water throughout the week.

Sketch of Installation with Triangulation or Distance to Specific Landmarks: NOT TO SCALE

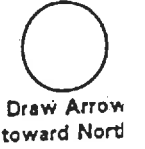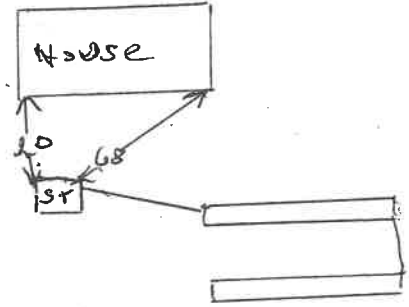

7-11-03
no well or cistern

Visit Date(s): 5-1-03
Final Inspection Date: 7-11-03

Sanitarian: J. Kauter