

STATE OF WEST VIRGINIA
Hardy County HEALTH DEPARTMENT
ON-SITE SEWAGE DISPOSAL SYSTEM PERMIT

Permit No.: ST - 16 - 00 - 062
Tax Map _____ Parcel # _____
County Road No.: _____

PERMIT TO BE
PRINTED OR TYPED

Owner: Richard C. Smith
Address: HC 66, Box 2
Moorefield, WV 26836

Certified Installer: Ralph Thorne, Jr
Address: 14 Jenkins Run Rd
Moorefield, WV

You are hereby issued a permit to: install, or modify an on-site sewage disposal system located:
Lot 4, Becky Webb Subdivision, Old Fields, WV

Facility: home Design Flow: 3 Bdrm Lot Size: 2.57 ~~SQ FT~~ Acres Water Source: public planned

BASED UPON REVIEW OF THE INFORMATION OF YOUR SUBMITTED APPLICATION DATED 5-17-00, AND THE PROPER INSTALLATION OF THE HEREIN DESCRIBED SYSTEM, THE SYSTEM SHALL BE IN COMPLIANCE WITH APPLICABLE WEST VIRGINIA SEWAGE SYSTEM RULES AND DESIGN STANDARDS.

The sewage system shall consist of a:

- Septic tank - Capacity : 1000 gallons or more, Constructed of: concrete
- Soil disposal system with a minimum equivalency of 900 square feet of conventional gravel trench area.
Depth to the bottom of the trench or bed installation shall be: _____ inches from original ground surface.
- Gravel system: Lengths of lines: _____, _____, _____, _____, _____, _____ feet, Width: _____ inches.
- Chamber system: Number of units: _____, Length of lines: _____, _____, _____, _____ units,
Manufacturer of chamber: _____
- Bed system: Gravel, Chamber; Length: _____ feet, Width: _____ feet.
- Other: 10 " Gravelless pipe consisting of 300 linear feet

This permit is non-transferable and automatically expires 12 months after issue date.


This permit is **NULL and VOID** when official inspection reveals conditions different than those stipulated on the permit or facts are later found that would indicate non-compliance with applicable rules.

All systems must be inspected and approved prior to being covered with earth or placed into use.

The applicant or his agent must notify this department: 24 hours or more prior to scheduled inspection time.

May 19, 2000
Issue Date
538-6355
County Office / Phone Number

Sketch of system:

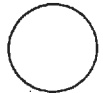

Draw Arrow
Toward North

Additional specifications
on reverse:

Lemoine K. Thompson, R.S.
Health Officer or Sanitarian
Lemoine K. Thompson, R.S.

2/25/96
PRINT:

STATE OF WEST VIRGINIA

Hardy HEALTH DEPARTMENT
APPLICATION FOR A PERMIT TO INSTALL OR MODIFY
A SMALL ON-SITE SEWAGE DISPOSAL SYSTEM

Perd Rec 2579

Property Owner: Richard C. Smith
Address: HC- 66 Box 2
Moorefield WV 26836
Phone: (home) 538-2297 (business) 538-7711

Certified Installer: Ralph Thorne Jr. Class: I II
Address: 14 Jenkins Run Rd Moorefield
WVA. 26836 Phone: 538-2943
Installer No.: 54-23-0025 WV Contractor's No.: WV012307

Directions to property: Rt 220 north, Old Fields Store turn Left
to Becky Webb Subdivision, Lot #4 across from Chicken Houses
Used facility to be served: (Please provide specific and detailed directions)

Residence, No. of bedrooms: 3 No. of individuals served: 2
Other, _____
Type served is: New Existing Water Source: Public in late fall
Property deed recorded in Book No.: _____ Page(s): _____
The property deed was recorded: _____

Unless the division of a tract, lot or parcel results in lots in excess of two acres and in which those lots have an average frontage of 150 feet or more, permits for individual sewage disposal systems shall be withheld until a completed application for the subdivision is approved which indicates that such systems may be expected to comply with applicable design standards on all proposed building lots contained within the original tract.

For a tract created after July 1, 1970, please refer to Subdivision box. \rightarrow
Minimum lot size or area reserved for a sewage disposal system in a subdivision may vary based on the date the subdivision was created.
Subdivision name: Becky Webb Approval number: _____
County tax map: _____ Parcel No.: _____ lot #4
of 2.57 square feet (acres)

I certify that to the best of my knowledge, the information provided with this application is true and I understand that I am responsible for employing a properly certified and licensed sewage system installer and for informing that installer of existing or proposed locations of any water sources and property lines. I further understand that it is my responsibility to consult the sanitarian for assistance as necessary and to determine the location of any existing water sources or water supply lines.
(Signature of the owner or authorized agent)

Application is herein made to: Install Modify a/an:
 Septic Tank Absorption Field Alternate System Other: _____

Percolation tests were conducted on 5/19/00, at a depth of 20-24 inches.
Time, in minutes, for the final 6 inch drop in each test hole is as follows:
Test Hole: #1 #2 #3 #4 6 feet hole free of Water and solid rock
Time: 265 272.5 278 297 Yes No

Minutes given for each percolation test hole are to be added together to give a total number of minutes: 1112.5
The total shall be divided by 24 in order to give the average time for a one inch drop: 44.5 (minutes per inch).

The undersigned certifies that the percolation test was conducted by the owner, or a certified installer, using approved procedures as outlined in the Design Standards. In the event that the percolation rate has received official approval in a subdivision application to the health department, the owner's signature shall certify the accuracy of the percolation test results for purposes of system design.

Signed: Ralph Thorne Jr. on this date: 5/19/00

Reverse side of form must be completed.

State of West Virginia

Hardy Co.

HEALTH DEPARTMENT

FOR HEALTH DEPARTMENT USE ONLY

COUNTY: _____

Date Recv'd. _____ Permit #: WW _____ ST _____

Coordinates: N _____ W _____

Date Site Evaluated: 10-20-92

Reviewed By: _____

PART I

APPLICATION FOR PERMIT TO CONSTRUCT, MODIFY OR ABANDON A WATER WELL

OR

INSTALL OR MODIFY A SMALL SEWAGE DISPOSAL SYSTEM

Instructions: Part I of this application is to be completed by the owner. State and county health department regulations require that water wells and sewage disposal systems be located, designed and constructed in accordance with published standards.

Property Owner: Benick Williams
(please print)

Address: Old Fields WV

Date: _____ Telephone: (home) _____ (business) _____

Water Well Sewage Disposal System

LOCATION OF PROPERTY (be specific) _____

Name of Subdivision: Becky Webb Section: _____ Lot: 4

Size of Lot: 2.528 sq.ft./acres Residence; No. of Bedrooms _____ No. of individuals served: _____

Other _____

Property Deed Recorded in Book No.: _____ Page: _____ Date Recorded: _____

To the best of my knowledge, the information provided on this application is true and I understand that I am responsible for informing the well driller and sewage system installer of the existing or proposed locations of sewage systems and well. I further understand that it is my responsibility to consult the sanitarian for assistance as necessary and to determine the location of the existing sewage system or well if said location is presently unknown to me.

(signature of owner)

PLEASE PROCEED TO COMPLETE PARTS II AND III, IF NECESSARY

PART II WATER WELL INFORMATION

Water well will be _____ constructed _____ modified and will be used for _____ potable water, _____ water exploration, _____ abandoned or other purposes: _____

Well Driller: _____ Phone No.: _____

Business Address: _____

Type of Casing: _____

Distance of Well from Potential Sources of Contamination:

Streams, Rivers & Impoundments _____ Sewers & Drains (non-watertight) _____ Privies (vault) _____

Sewage Absorption Fields _____ Sewers & Drains (hydrostat. tested) _____ Barnyard/Feeding _____

Septic Tank _____ Sewage Holding Tank _____ Water Areas _____

Other: _____

SIGNATURE of DRILLER _____ CERTIFICATION # _____ DATE _____

STATE OF WEST VIRGINIA

INSPECTION TO BE PRINTED OR TYPED

HARDY CO HEALTH DEPARTMENT

Permit No.: ST-16-00-062

County: HARDY

ON-SITE SEWAGE DISPOSAL SYSTEM INSPECTION FORM

Tax Map: Parcel #:

County Road:

Name of Owner: RICHARD C. SMITH Installer: RALPH THANE, JR
Address: HC 66, Box 2, MOOREFIELD, WV 26836
Property Location: Lot 4, BECKY WEBB, OLD FIELDS, WV
Type of Facility: HOME Facility is: New (X) Existing () Lot Size: 2.57 S.Ft./Acres
Design Loading in gpd/No. Bedrooms: 3 Born Source of Water Supply: PUBLIC

SEWAGE TANK COMPONENT

Capacity in Gallons: 1000 Material: CONCRETE Manufacturer:
Distances (in feet) of Tank to: Dwelling: 12' Private ()/Public (X) Water Source: >25' Property Line: >10'

ON-SITE DISPOSAL SYSTEM

Class I Systems: Standard Soil Absorption Trenches () or Bed () Gravelless Pipe (X), Diameter: 10 Inches
Chamber Soil Absorption Trenches () or Bed ()
Class II Systems: Pumped/Dosed Soil Absorption Trenches () or Bed () Evapotranspiration Trenches () or Bed ()
Shallow Soil Absorption Trenches () or Bed () Other:

No. of Lines: 3 Length (in feet) of Each: 100, 100, 100,
Width of Trenches: 24 inches/feet Depth to Bottom of Field: 24-30 inches

Bed, Dimensions (in Feet): If Chamber System, Name: No. of Units:


Approved and Adequate Materials Used? Yes (X) No () Size Equates to: 900 Square Feet of Standard Gravel Field.

Distances (in feet) of System to: Dwelling: 21' Private ()/Public (X) Water Source: >25' Property Line: >10'

Notes:

An inspection indicates that the sewage disposal system described above DOES MEET (X), DOES NOT MEET (), or CANNOT BE DETERMINED TO MEET () the minimum standards established by the West Virginia Bureau of Public Health. To correct a health hazard, modifications to existing systems may be done to improve part of a system. Such modifications may not be able to be designated as a does meet system since adequate information is known. Although many factors contribute to the successful functioning of a sewage disposal system, this office recommends water conservation and utilizing an even usage of water throughout the week.

Sketch of Installation with Triangulation or Distance to Specific Landmarks:

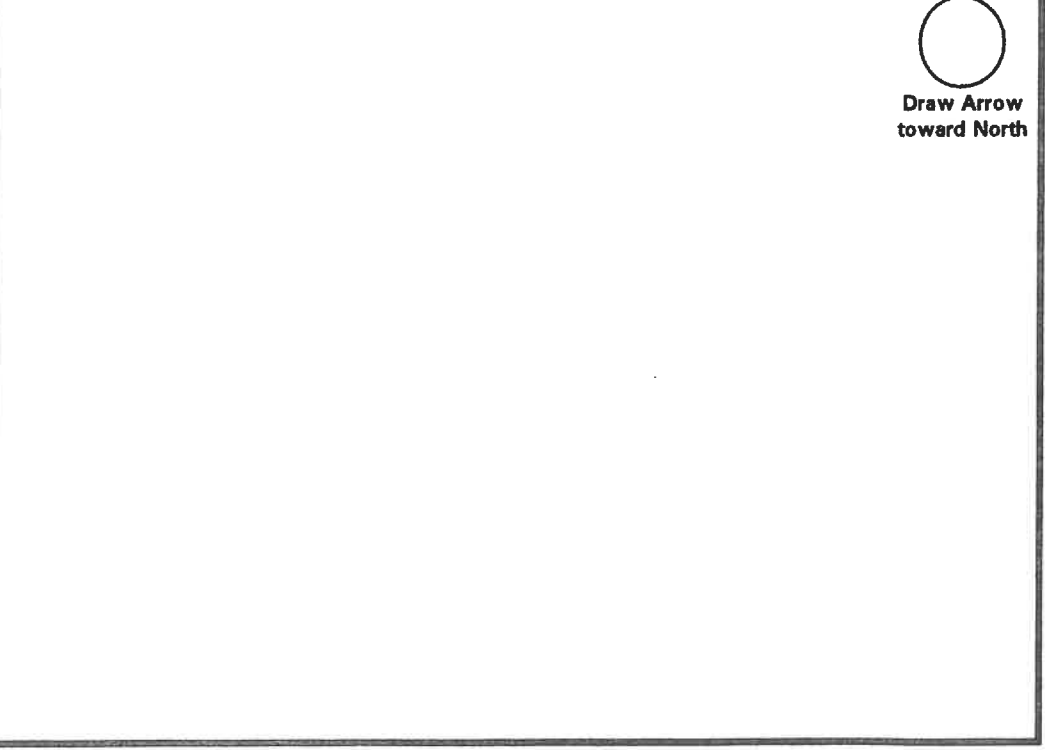

Visit Date(s):

Final Inspection Date: 6-8-00

Sanitarian: Lenore K. Thompson, R.S.