

10-30-94 13:34 FROM-

T-760 P0003 F-766  
Permit No.: 51-1-00-1-16  
Tax Map: Parcel #:  
County Road:

INSPECTION TO BE PRINTED OR TYPED

AMPTON CO HEALTH DEPARTMENT  
ON-SITE SEWAGE DISPOSAL SYSTEM  
INSPECTION FORM

County: Hampshire

Name of Owner: Amos Babb Installer: O Wilson

Address: 12201 Hopkins Gap Rd, Funks Run VA 29530

Property Location: SHIRT MOUNTAIN HEIGHTS PARCEL # 6

Type of Facility: None Facility is: New ( ) Existing (X) Lot Size: 2.1 Sq. Ft./Acres

Design Loading in gpd/No. Bedrooms: Source of Water Supply: well

SEWAGE TANK COMPONENT

Capacity in Gallons: 1000 Material: concrete Manufacturer: John

Distances (in feet) of Tank to: Dwelling: 20 Private (X) Public ( ) Water Source: 98 Property Line: 50

ON-SITE DISPOSAL SYSTEM

Class I Systems: Standard Soil Absorption Trenches ( ) or Bed ( ) Gravelless Pipe ( ), Diameter: inches  
Chamber Soil Absorption Trenches ( ) or Bed ( )  
Class II Systems: Pumped/Dosed Soil Absorption Trenches ( ) or Bed ( ) Evapotranspiration Trenches ( ) or Bed ( )  
Shallow Soil Absorption Trenches ( ) or Bed ( ) Other:

No. of Lines: 2 Length (in feet) of Each: 90, 90

Width of Trenches: 36 inches/feet Depth to Bottom of Field: 20 inches

If Bed, Dimensions (in Feet): If Chamber System, Name: infiltrator No. of Units: 30

Approved and Adequate Materials Used? Yes (X) No ( ) Size Equates to: Square Feet of Standard Gravel Field.

Distances (in feet) of System to: Dwelling: 35 Private ( ) Public ( ) Water Source: 120 Property Line: 10


Remarks:

An inspection indicates that the sewage disposal system described above **DOES MEET** (X) **DOES NOT MEET** ( ) **CANNOT BE DETERMINED TO MEET** ( ) the minimum standards established by the West Virginia Bureau of Public Health.

To correct a health hazard, modifications to existing systems may be done to improve part of a system. Such modifications may not be able to be designated as a does meet system since inadequate information is known.

Although many factors contribute to the successful functioning of a sewage disposal system, this office recommends water conservation and maintaining an even usage of water throughout the week.

Sketch of installation with Triangulation or Distance to Specific Landmarks:

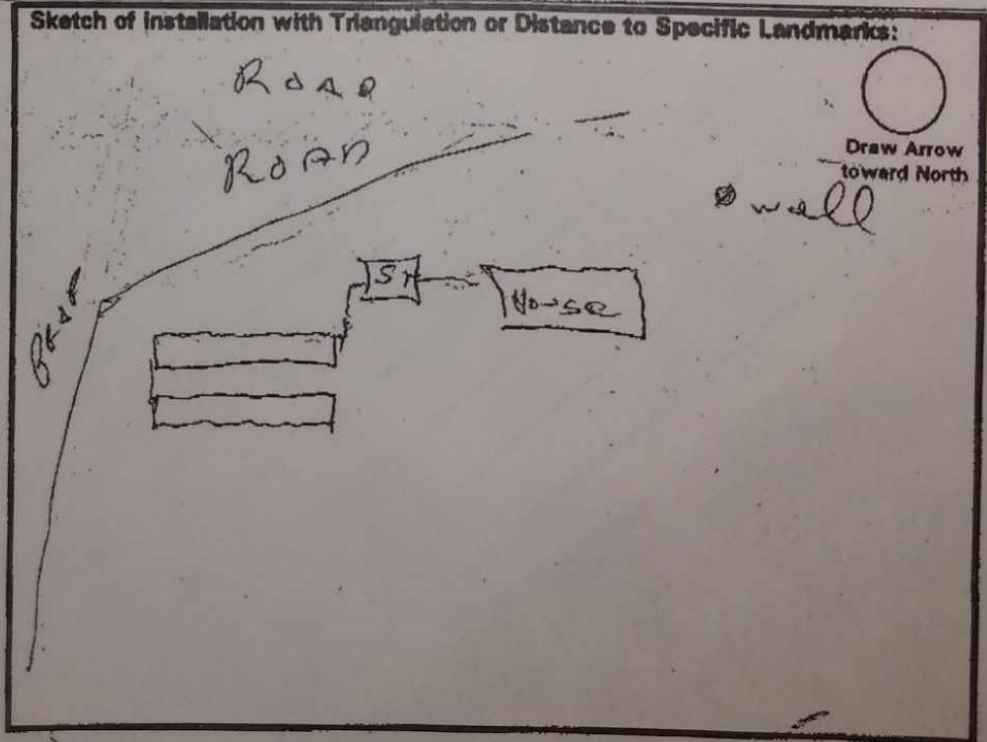

Visit Date(s): 11-23-99

Final Inspection Date: 12-3-99

Sanitarian: [Signature]