

WEST VIRGINIA
SEPTIC TANK INSPECTION FORM

Chambers County Health Department Installation Permit No. ST-14-90-291
Name of Owner Walter D. Perry
Address St. Rt. 1, Box 36 A, Augusta, WV 26204
Property Address Bellevue Sub., lot #13

DESCRIPTION & NUMBER OF UNITS SERVED

Type Facility Served House No. Water Closets 1
Lot Size 5+ ^{acres} sq. ft. Area suitable for sewage disposal installation 1 sq. ft.
Source of Water Supply Well No. Lavatories 1
No. Bedrooms 3 No. Showers or Tubs 1 No. Baths 1
No. Garbage Grinders 1 No. Automatic Washers 1

SEPTIC TANK

Material pre-cast concrete Length x Width x Depth = cubic feet
Liquid Depth ft. Liquid Capacity 1,000 gal.
Distance to: Dwelling 30' Water Supply 80' Nearest Property Line 1

SOIL ABSORPTION SYSTEM

Type Drain Line Material plastic Trench Width 36 Inches
Trench Depth 24 Inches Total Absorption area in Trench Bottom 820 sq. ft.
Diameter of Drain Line 4 Inches Type Filter Media gravel - 40 tons
No. of Drain Lines 3 Depth Filter Media Under Drain Line 9 Inches
Length of Each Line 120, 85, 85 ft. Depth Filter Media Over Drain Line 6 in
Distance of Disposal Field to: (a) Dwelling 90'
(b) Water Supply 100' (c) Nearest Property Line 50'


An inspection of the septic tank system described herein disclosed that said system (MEETS, DOES NOT MEET) the minimum standards established by the West Virginia State Department of Health.

4-5-90
Date

[Signature]
Sanitarian

SKETCH OF SYSTEM TO BE DRAWN ON BACK

Note: Copy of this inspection report must be given to owner and the original filed in the Health Department files. PERMANENT RECORD - DO NOT DESTROY.

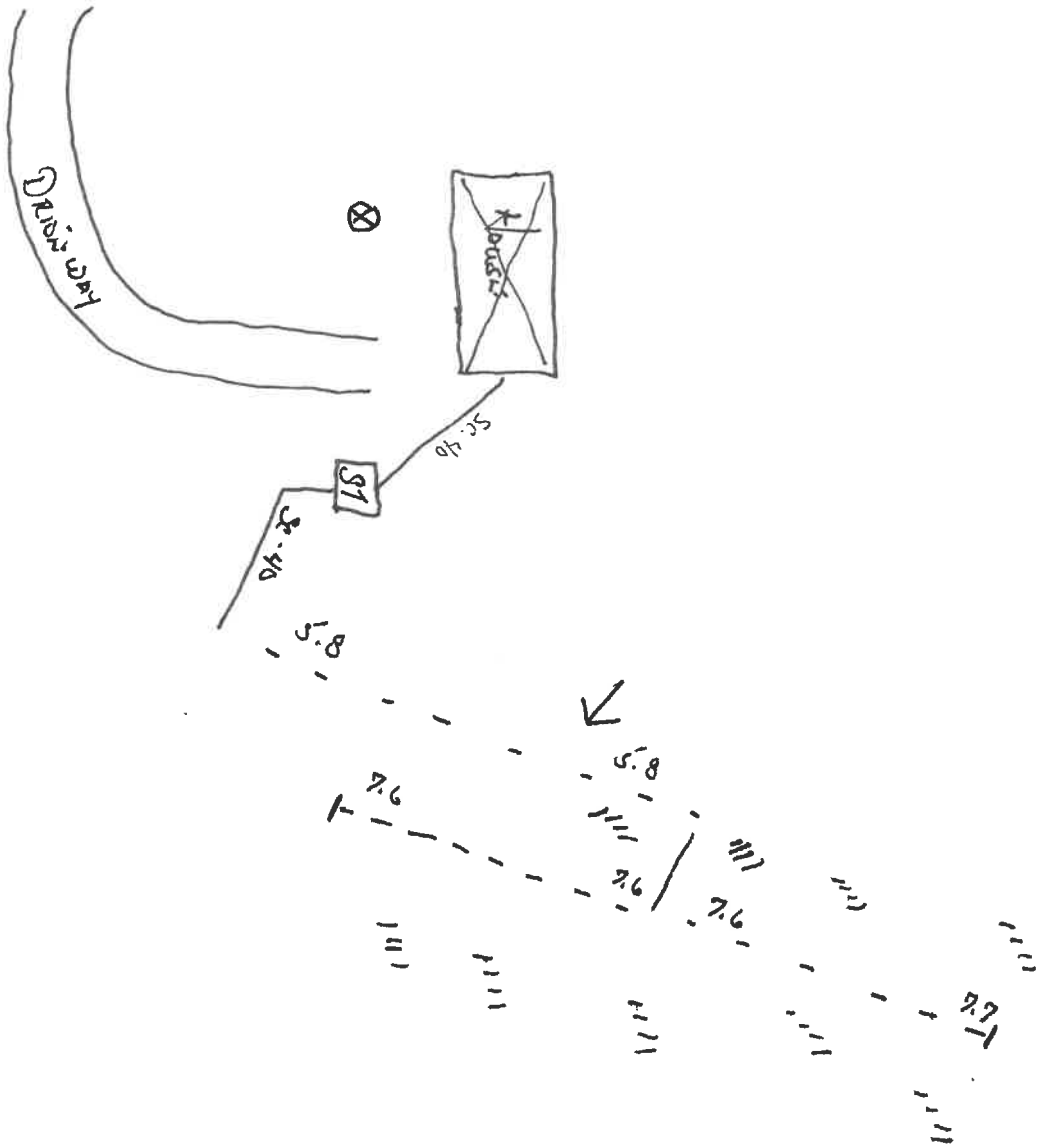

Replaced drain line from Septic tank to Pond
and absorption field only