

Hampshire County Health Department
On-Site Sewage Disposal System
Inspection Form

Permit # ST-14-11-86

Name of Owner: Richard Lane Installer: Jason Hott

Address: P.O. Box 155, Smithsburg, MD 21783

Property Location: Spring Gap Mountain Lot 17 Lot Size: 5.01AC Acres

Type of Facility: Residence Facility is: New Existing

Design Loading in gpd/# Bedrooms: 2 Source of Water: Well

SEWAGE TANK COMPONENT

Capacity in Gallons: **1000** Material: precast concrete Pump Chamber gal

Distances (in feet) of Tank to: Dwelling

Private Public Water Source: Property Line: **>100'**

ON-SITE DISPOSAL SYSTEM

Class I Systems: Standard Soil Trenches() or Bed() Gravelless Pipe(), Diameter In.
 Chamber Soil Absorption Trenches(**X**) or Bed()

Class II Systems: Pumped/Dosed Soil Absorption Trenches () or Bed () LPP ()

Evapotranspiration Trenches () or Bed ()

Shallow Soil Absorption Trenches () or Bed () Other:

No. of Lines: **3** Length (in feet): **80'**

Width of Trenches: **36** inches/feet Depth to Bottom of Field: **24** inches

If Bed, Dimensions (in feet): Size Equates to **1200sq ft** of SGF

Distance (in feet) of System to: Dwelling

Private () Public () Water Source: Property Line: **40'**

Remarks: **Dwelling/well not constructed at time of inspection**

GPS: N39 27 23.6 w78 29 52.9

An inspection indicates that
 The sewage disposal system
 Described above

DOES MEET X

DOES NOT MEET or


CANNOT BE DETERMINED TO

MEET the minimum standards
 Established by the West Virginia
 Bureau of Public Health.

To correct a health hazard,
 Modifications to existing systems
 May be done to improve part of a
 System. Such modifications may
 Not be able to be designated as
 a **Does meet** system since
 Inadequate information is known.

Although many factors
 Contribute to the successful
 Functioning of a sewage disposal
 System, this office recommends
 Water conservation and
 Maintaining an even usage of
 Water throughout the week.

Visit Date(s):

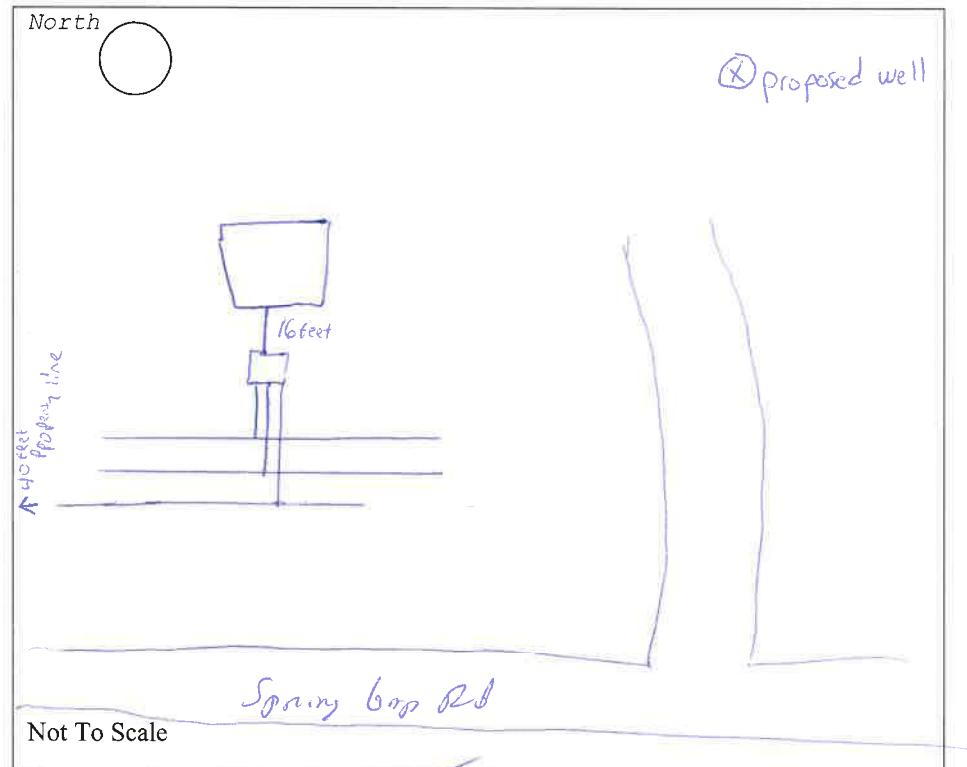

FINAL INSPECTION DATE: 4/27/2011

SANITARIAN: John Mink

SEWAGE DISPOSAL SYSTEM INFORMATION

Application is for a permit to: Install Modify
Check all that apply: Septic Tank Absorption Field Holding Tank Pit Privy Vault Privy
 Alternate System (attach detailed plans) Chemical/Composting Toilet Other: _____

Septic Tank: Capacity (gallons) 1000 Material Concrete Manufacturer Toln

Absorption Field: Equivalent to 1200 sq.ft. of conventional gravel trench system.

Trench System: No. of lines _____ Lengths _____ ft. Pipe ASTM No. _____

Gravel Trench Width _____ inches; or Gravelless Pipe Diameter _____ inches.

Chamber System: Manufacturer INF 4 No. of Chambers 60

Soil Absorption Bed (Requires oversizing of bottom surface area by 30%).

If soil absorption bed: Length _____ feet by Width _____ feet Pipe ASTM No. _____

If chamber system: Manufacturer _____ No. of Chambers _____

Distances in feet (to nearest) Septic tank to Bldg. foundation 20+ Property line 20+ Water supply 50+
Absorption field to: Bldg. foundation 20+ Property line 20+ Water supply 100+

I hereby certify that the installation or modification of all parts of the sewage disposal system, including required material standards, will be done in compliance with applicable design standards issued by the Office of Environmental Health Services, and appropriate manufacturer's recommended procedures and practices.

Installer (please print) Jason Hott Telephone 304-496-1277

Business Address HC 78 Box 163 Augusta WV 26704

Installer's Certification Number 54-05-A-00719 Expiration Date _____

Dept. of Labor Contractor's License No. 044800 Exp. Date 11/12/11 Issued to J.M. Hott Excavating

Date: 4/4/11


Signature of Installer: Jason Hott

SKETCH

Draw a sketch of the property showing existing or proposed well locations that would be within 200 feet of the proposed on-site sewage system, location of structures, and property line locations. Show all structures or facilities to be served by on-site sewage system on the lot or tract.

House -x- Water supply line Water Supply ||||| Trees P Percolation test site ST Septic tank

----- Soil absorption line Direction of ground slope _____ Property line MH Mobile Home

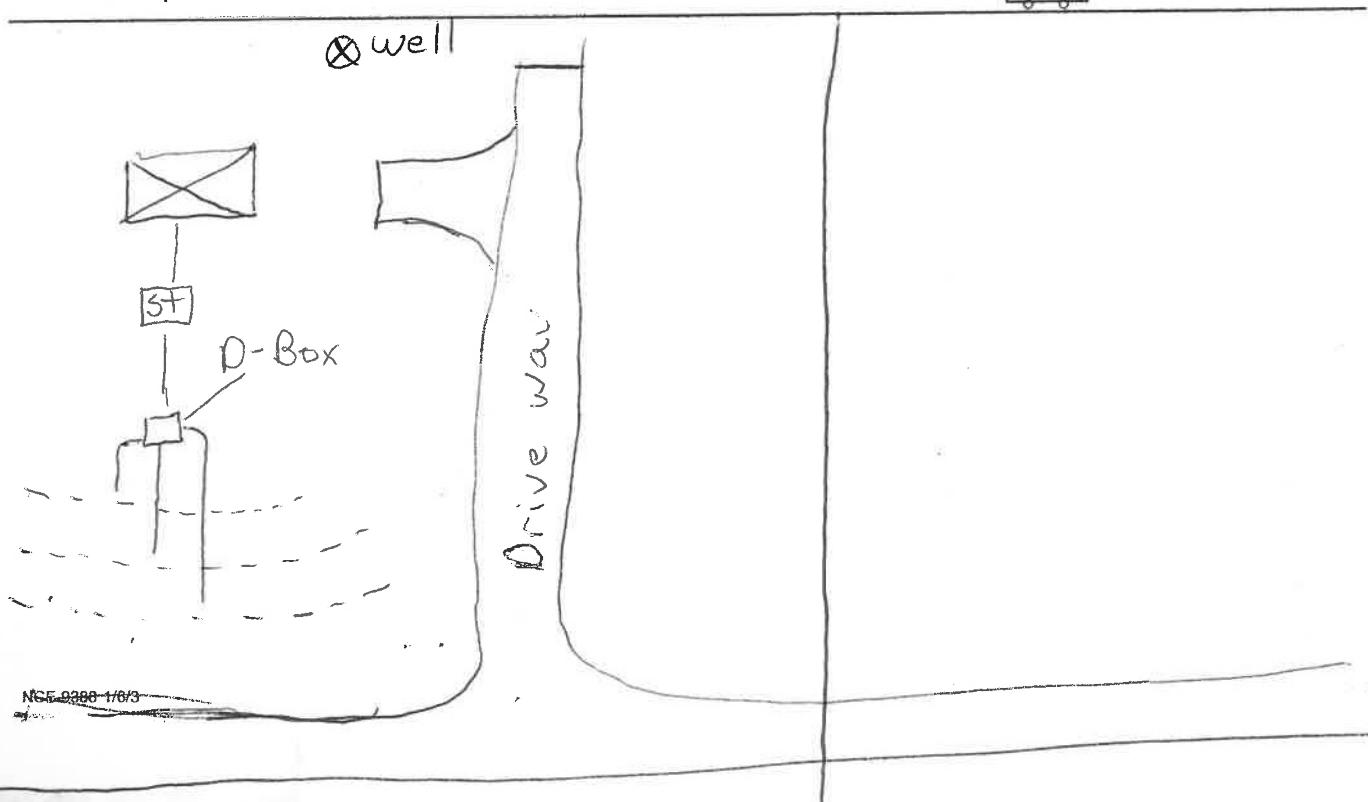

ST/CO USE ONLY
DATE RECEIVEDDATE THE WELL
WAS COMPLETED

MM DD YY

6 13 2011

STATE OF
WEST VIRGINIA
WATER WELL
COMPLETION
REPORT

MM DD YY

PERMIT NO.

DW- 14-18-084

FORM SW-258

THIS REPORT MUST BE
SUBMITTED WITHIN 30 DAYS
AFTER WELL IS COMPLETED

FILL IN THIS FORM

COMPLETELY

PLEASE PRINT OR TYPE

LOCATION OF WELL

Well Owner: Last Name Lane

First Name RICHARD

Street/Road SPRING GAP

County HAMPSHIRE

Zip Code

Latitude: _____ Deg _____ Min _____ Sec

Longitude: _____ Deg _____ Min _____ Sec

Acquired By: GPS Topo Other

AREA NAME/LOCATION:

6.5 miles on Spring Gap Rd
on Right

Spring Gap Lot 17

TYPE OF WELL:

Potable Public Water Supply
 Geothermal Industrial
 Commercial Dewatering
 Irrigation Test/Exploratory
 Other

WELL LOG

Depth

State the kind of formation
penetrated, their color, caves,
and if water bearing with
estimate flow (GPM).

DRILLING METHOD

Cable Tool Rotary
 Rotary Hammer Other

Hole Diameter 6 (in)

Total depth (ft)

CASINGS RECORD

MAIN CASING TYPE DRIVE
 Steel Plastic SHOE Other

Casing Diameter 6 5/8 (in)

Wall Thickness .188 (in)

Casing Length 100 (ft)

Other Casing or Liner Used

Type Steel Plastic Other CERTA-LOK

Casing/Liner Diameter 4 (in)

Length 260 (ft) from 0 (ft)

to 260 (ft)

SCREEN RECORD

 Not Installed InstalledMaterial: Bronze Plastic

Diameter of screen 4 (in)

Slot size .020"

Length 40 (ft) from 260 (ft)

to 300 (ft)

GRAVEL PACK RECORD

Gravel Pack: Yes No

From (ft) to (ft)

If additional space is needed, use
additional sheets and attach w/permit # at
top.I hereby certify that this well has been constructed in accordance with state rules and in conformance with
all conditions stated in the above captioned permit, and that the information presented herein is accurate
and complete to the best of my knowledge.

Company Name B.W. SMITH WELL DRILLING WV Contractor No. 038905

Business Registration No. 1005-3775 Master Well Driller Certification No. 574

Master Well Driller (print) Chris Wolford

Master Well Driller Signature Chris Wolford

SITE SUPERVISOR (SIGNATURE OF DRILLER OR JOURNEYMAN RESPONSIBLE FOR
SITWORK IF DIFFERENT FROM MASTER DRILLER.)

Journeyman Well Driller Certification No. _____

Journeyman Well Driller (please print) _____

Apprentice and Name (s) _____

GROUTING RECORD

Grouting Material:

 Cement Bentonite Clay

Other _____

No. of Bags: 5

Installation Method:

PRESSURE

PUMP INSTALLED

By Driller Yes No

ESTIMATED WELL YIELD

Estimated at 8 G.P.M

Static Water Level 115 (ft)

*Pumping level below land surface

248 (ft) after 1 hrs. at

8 G.P.M. (Estimated)

*Note: For Public Water Supply
wells please submit required yield
and drawdown tests.

WELL HEAD COMPLETION

Casing height above grade 1 (ft)

Type Of Well Cap

Installed: _____

VARIANCE ISSUED Yes No

Request Number _____

COMMENTS BY INSTALLER:


SET PUMP ABOVE 260'

NO TORQUE ARRESTOR


NO CABLE GUARDS

NO ROPE

Please draw a sketch of the property showing existing or proposed well locations, and distances to structures, existing or proposed sewage systems within 100 feet of well location (include adjacent lots). Slope and lot dimensions need to be shown. Locate and show distances to animal pens and feedlots. Note sewage treatment facilities within 200 feet and fertilizer and pesticide storage or preparation areas within 150 feet.

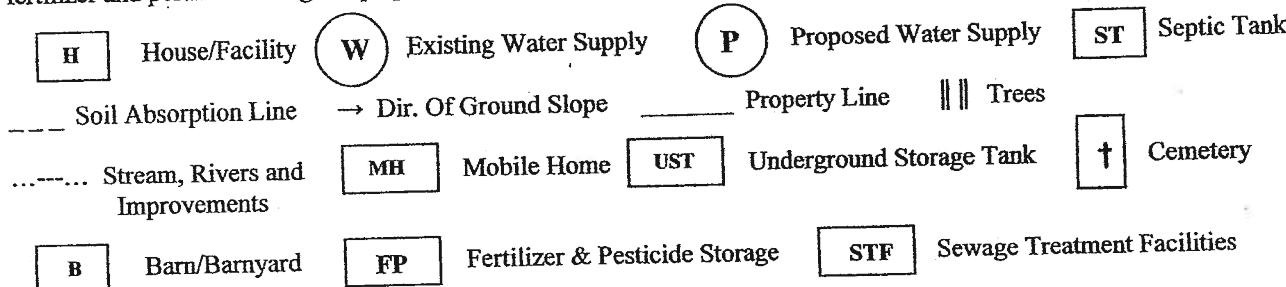

North

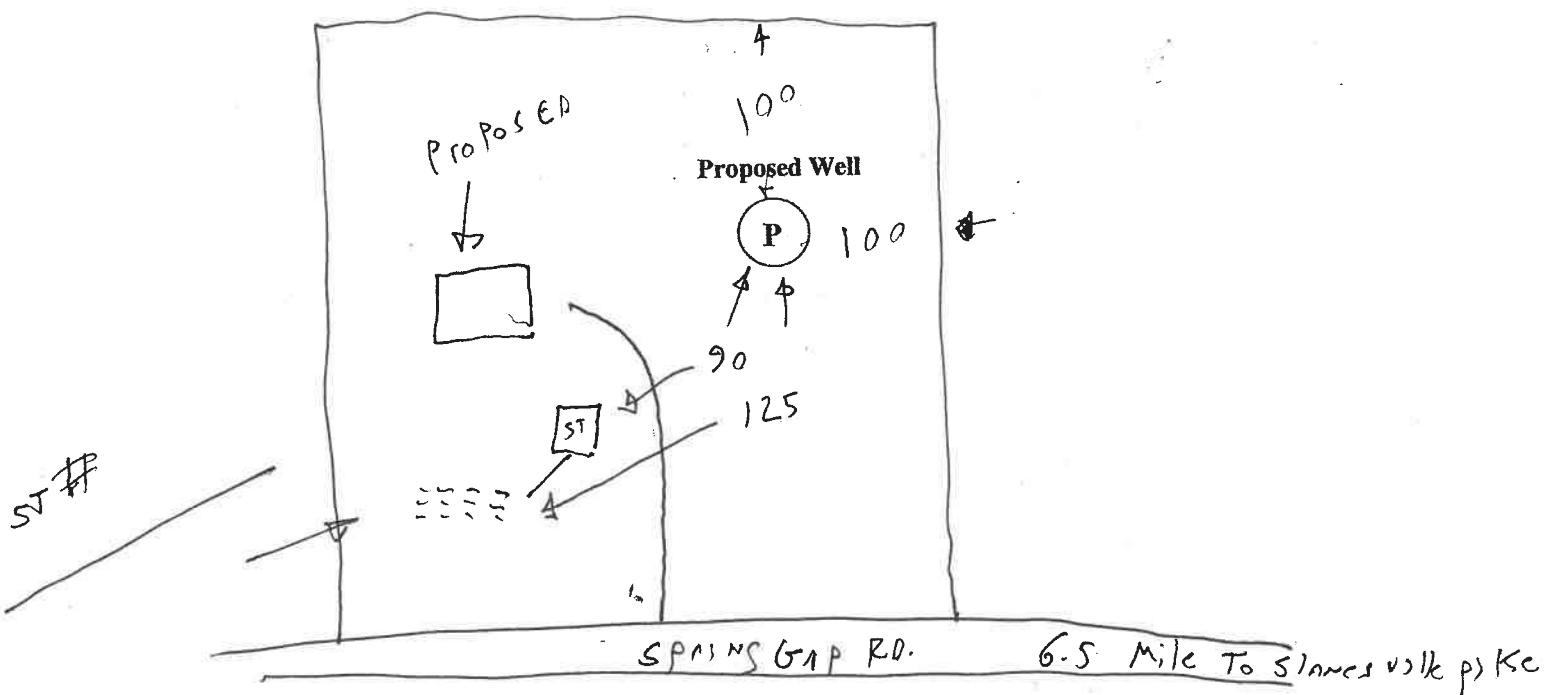

For Health Department Use Only

County: _____ Coordinates: Lat: _____ Long: _____ Date Received: 04-29-2011
Date Site Evaluation: _____ Reviewed by: _____ Date Fee Paid: 04/29/2011 Rec'd From: Richard Lane
Contractor's Bond Letter of Credit Exp. Date Verified By: _____ Liability Insurance Exp. Date Verified by: _____
Water Well Permit Issued Denied Permit No. DW-14-11-084 Comments: _____

Receipt # 1894