

WEST VIRGINIA
SEPTIC TANK INSPECTION FORM

Hampshire County Health Department Installation Permit No. ST-14-94-165
 Name of Owner Richard J. Lucha
 Address 4116 Perry View Rd., Baltimore, MD 21236
 Property Address Persimmon Valley Estates Lot #11

DESCRIPTION & NUMBER OF UNITS SERVED

Type Facility Served house No. Water Closets
 Lot Size 2.53 ^{acres} sq. ft. Area suitable for sewage disposal installation sq. ft.
 Source of Water Supply well No. Lavatories
 No. Bedrooms 2 No. Showers or Tubs No. Baths
 No. Garbage Grinders 0 No. Automatic Washers

SEPTIC TANK

Material precast Length x Width x Depth = cubic feet
 Liquid Depth ft. Liquid Capacity 1000 gal.
 Distance to: Dwelling 8' Water Supply 100 Nearest Property Line 70'

SOIL ABSORPTION SYSTEM

Type Drain Line Material gravel Trench Width 24 Inches
 Trench Depth 24 Inches Total Absorption area in Trench Bottom 900 sq. ft.
 Diameter of Drain Line 10 Inches Type Filter Media
 No. of Drain Lines 5 Depth Filter Media Under Drain Line Inches
 Length of Each Line 60, 60, 70, 70 ⁴⁰ ft. Depth Filter Media Over Drain Line in
 Distance of Disposal Field to: (a) Dwelling 38'
 (b) Water Supply (c) Nearest Property Line 70'


An inspection of the septic tank system described herein disclosed that said system (MEETS, DOES NOT MEET) the minimum standards established by the West Virginia State Department of Health.

4-13-94
Date

[Signature]
Sanitarian

SKETCH OF SYSTEM TO BE DRAWN ON BACK

Note: Copy of this inspection report must be given to owner and the original filed in the Health Department files. PERMANENT RECORD - DO NOT DESTROY.

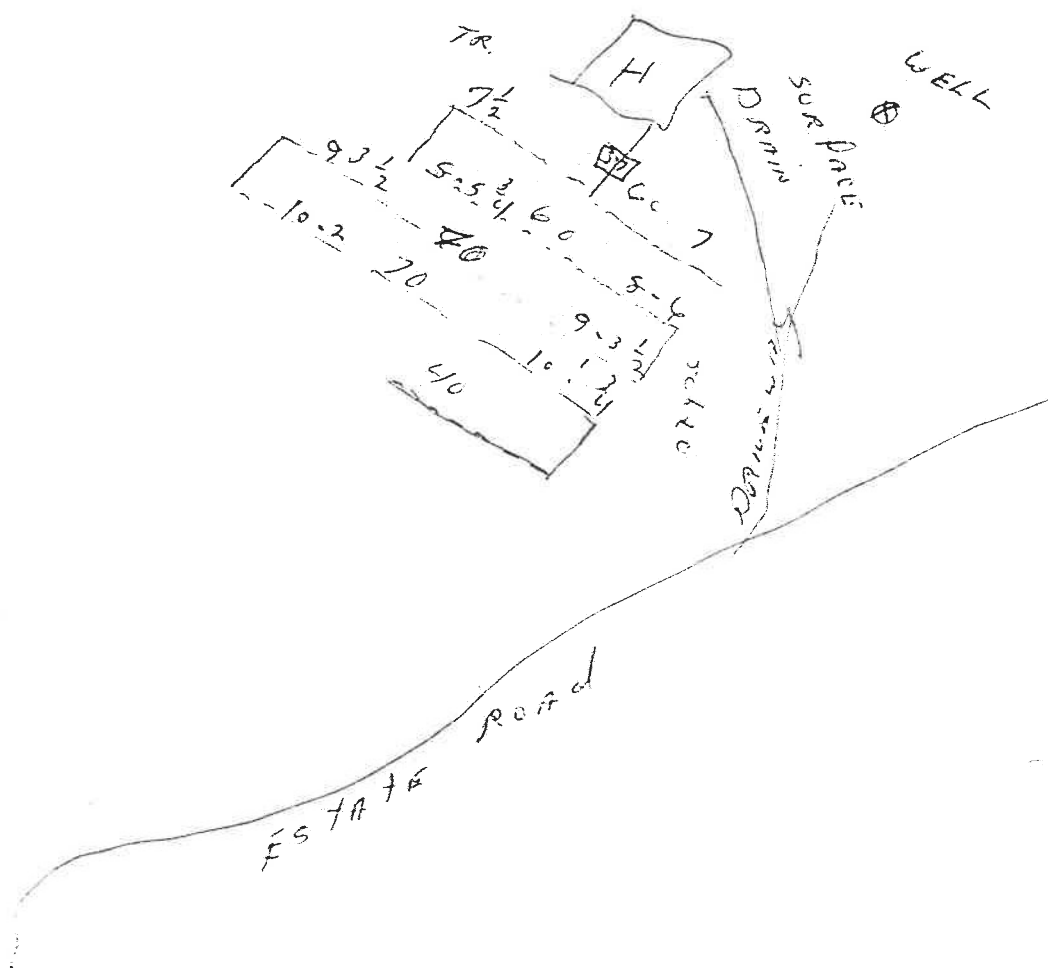

WEST VIRGINIA
SEPTIC TANK INSPECTION FORM

Nimrod County Health Department Installation Permit No. ST-14-91-182

Name of Owner Harry Cates

Address Box 289 Night View, WV

Property Address Peaceful Valley Est. Lot #15

DESCRIPTION & NUMBER OF UNITS SERVED

Type Facility Served cabin No. Water Closets

Lot Size 3 ^{acres} ~~sq. ft.~~ Area suitable for sewage disposal installation sq. ft.

Source of Water Supply well No. Lavatories

No. Bedrooms 2 No. Showers or Tubs No. Baths

No. Garbage Grinders 0 No. Automatic Washers 0

SEPTIC TANK

Material concrete tank Length x Width x Depth = cubic feet

Liquid Depth ft. Liquid Capacity 1000 gal.

Distance to: Dwelling 15' Water Supply 120' Nearest Property Line 160'

SOIL ABSORPTION SYSTEM

Type Drain Line Material plastic Trench Width 36 Inches

Trench Depth 24 Inches Total Absorption area in Trench Bottom 600 sq. ft.

Diameter of Drain Line 4 Inches Type Filter Media gravel

No. of Drain Lines 2 Depth Filter Media Under Drain Line 12 Inches

Length of Each Line 100, 100, , ft. Depth Filter Media Over Drain Line 4 in.

Distance of Disposal Field to: (a) Dwelling 25'

(b) Water Supply 110' (c) Nearest Property Line 50'


An inspection of the septic tank system described herein disclosed that said system (MEETS, DOES NOT MEET) the minimum standards established by the West Virginia State Department of Health.

3-26-80
Date

[Signature]
Sanitarian

SKETCH OF SYSTEM TO BE DRAWN ON BACK

Note: Copy of this inspection report must be given to owner and the original filed in the Health Department files. PERMANENT RECORD - DO NOT DESTROY.

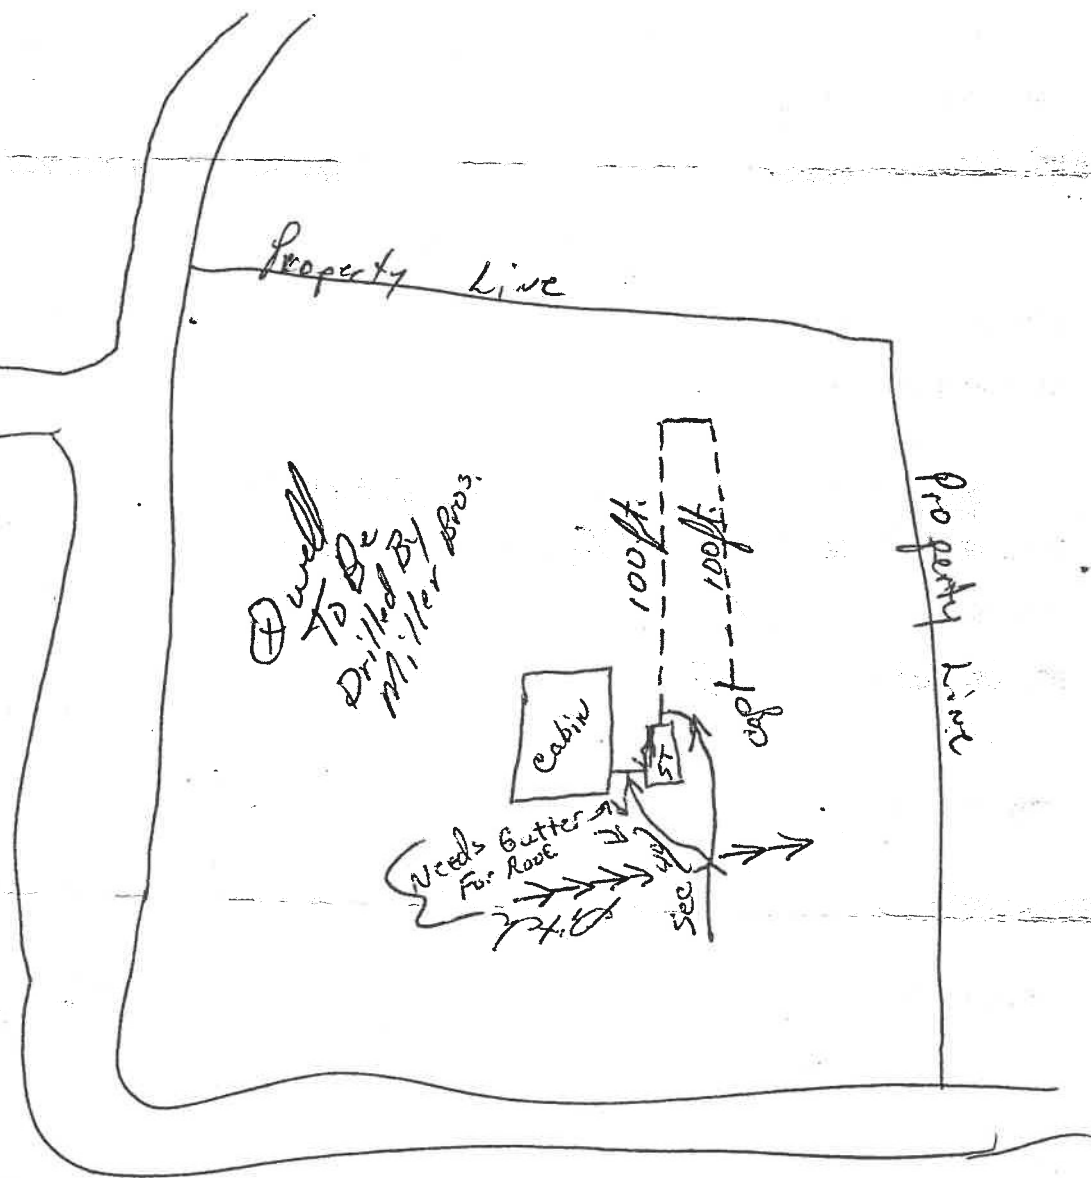

WV STATE DEPARTMENT OF HEALTH
Office of Environmental Health Services
ENVIRONMENTAL ENGINEERING DIVISION

SW258

WELL COMPLETION REPORT

Date(s) 10-1-90 County HAMPSHIRE Permit #: DW-14-06-90-337
Town: KIRBY Area Name/Location PEACEFUL VALLEY ESTATES LOT #15
Well Owner: HARRY OATES Address: P.O. Box 289
Telephone Number: 304-856-2516 HIGHVIEW W. VA. 26308
Well Driller: RANDAL G MILLER Address: Box 186
Telephone Number: 304-738-3266 ROBELEY W. VA. 26753

WELL LOG

DEPTH IN FEET	FORMATIONS: KIND, THICKNESS, AND IF WATER BEARING	REMARKS:
0-51'	YELLOW SAND (UNCONSOLIDATED)	Type of Well: <u>DW</u> Drilling Method: <u>AIR ROTARY HAMMER</u>
51'	RED SANDSTONE (BEDROCK)	Well Diameter: <u>6 1/8"</u> Casing O.D.: <u>6 5/8"</u>
62'	RED SANDSTONE (CONSOLIDATED)	Well Depth: <u>225'</u> Date Completed: <u>10-1-90</u>
	CEMENT + SET CASING	CASING: Length <u>63</u> Feet Height above ground <u>1</u> Feet
90'	BLUE SANDSTONE (WATER 2 GPM)	☒ Steel ☐ Plastic ☐ Cast Iron
138'	BLUE SANDSTONE (WATER 3 GPM)	Other _____ Type _____
196'	BLUE SANDSTONE (WATER 20 GPM)	
225'	BLUE SANDSTONE (CONSOLIDATED)	
	STOPPED DRILLING	
		SCREEN
		☒ None Installed
		Type _____ Diameter _____
		Slot/Gauge _____ Length _____
		Set Between _____ Ft. and _____ Ft.

PUMPING OR BAILING TEST

DETAILS	#1	#2	#3
Static Water Level (Ft. Below Grade)	<u>50</u>		
Pumping Rate (GPM)	<u>25</u>		
Pumping Level (Ft Below Grade)	<u>215</u>		
Duration of Test (In Hours)	<u>2</u>		
Recovery Time to Static Level (In Hours)	<u>1</u>		

WELL HEAD

Pitless Adapter: Type, Make, Etc. _____
Well Cap: Type, Make, Etc. ROVER - CONDUIT TYPE
Well Seal: Type, Make, Etc. _____
Well Platform: TO BE INSTALLED BY OWNER
Length _____ Width _____ Thickness _____
Grouting: ☐ Yes ☒ No
All Public Water Supplies must be grouted.

I hereby certify that this well was drilled and constructed under my supervision, in compliance with all requirements of the referenced permit, and that this record is true to the best of my knowledge and belief.

RANDAL G MILLER 432
Name Certification No.
MILLER BROS. DRILLING
Registered Business Name
RANDAL G MILLER 10-1-90
Signed Date