

PERMIT TO BE  
PRINTED OR TYPEDSTATE OF WEST VIRGINIA  
HEALTH DEPARTMENT  
ON-SITE SEWAGE DISPOSAL SYSTEM PERMITPermit No.: ST-14-99-094  
Tax Map \_\_\_\_\_ Parcel # \_\_\_\_\_  
County Road No.: \_\_\_\_\_Owner: Mabride InvestmentsCertified Installer: Calvin DavisAddress: HC-71 Box 44Address: HC-78 BOX 110-DAugusta WV 26704Delray, WV 26714You are hereby issued a permit to: ☒ install, or ☐ modify an on-site sewage disposal system located:GOLDEN ACRES MOBILE HOME PARK corner of A.A. Rodgers  
road & RT 50Facility: Mobile Home Design Flow: 6 DR Lot Size: 20 ~~Sq.~~ Ft./Acres Water Source: WellBASED UPON REVIEW OF THE INFORMATION OF YOUR SUBMITTED APPLICATION, DATED 9-11-98, AND THE PROPER INSTALLATION OF THE HEREIN DESCRIBED SYSTEM, THE SYSTEM SHALL BE IN COMPLIANCE WITH APPLICABLE WEST VIRGINIA SEWAGE SYSTEM RULES AND DESIGN STANDARDS.

## The sewage system shall consist of a:

- ☒ Septic tank - Capacity: 1500 gallons or more, Constructed of: Concrete.
- ☒ Soil disposal system with a minimum equivalency of 1200 square feet of conventional gravel trench area.
- Depth to the bottom of the trench or bed installation shall be: 24-36 inches from original ground surface.
- ☒ Gravel system: Lengths of lines: 120, 100, 100, 100, \_\_\_\_\_ feet, Width: 36 inches.
- ☐ Chamber system: Number of units: \_\_\_\_\_, Length of lines: \_\_\_\_\_, \_\_\_\_\_, \_\_\_\_\_, \_\_\_\_\_ units, Manufacturer of chamber: \_\_\_\_\_.
- ☐ Bed system: ☐ Gravel, ☐ Chamber; Length: \_\_\_\_\_ feet, Width: \_\_\_\_\_ feet.
- ☐ Other: may also be 10" GDAWELLES or equivalent 36" chamber system

This permit is non-transferable and automatically expires 12 months after issue date.

This permit is **NULL and VOID** when official inspection reveals conditions different than those stipulated on the permit or facts are later found that would indicate non-compliance with applicable rules.

All systems must be inspected and approved prior to being covered with earth or placed into use.

The applicant or his agent must notify this department: 72 hours or more prior to planned inspection time.

Sketch of system:

⊗ well

1500 GALLON  
TANK

ADD

at least

100' line

\* design and location to  
be determinedDraw Arrow  
Toward North

Issue Date

9-17-98

County Office / Phone Number

822-5111Additional specifications  
on reverse:

Health Officer or Sanitarian

INSPECTION TO BE  
PRINTED OR TYPED

## STATE OF WEST VIRGINIA

Hampshire County HEALTH DEPARTMENT

ON-SITE SEWAGE DISPOSAL SYSTEM  
INSPECTION FORM

Permit No.: ST-1499-894

Tax Map: \_\_\_\_\_ Parcel #: \_\_\_\_\_

County Road: \_\_\_\_\_

Name of Owner: MC BRIDE INVESTMENT Installer: CALVIN DAVIS  
 Address: NC 78 Box 44 Augusta WV 26704  
 Property Location: RT. 50 Corner of AA Rodgers Rd  
 Type of Facility: 2 Mobile Homes Facility is: New ( ) Existing ( ) Lot Size: 2.0 Sq. Ft./Acres  
 Design Loading in gpd/No. Bedrooms: 2 Mobile Homes Source of Water Supply: Well

## SEWAGE TANK COMPONENT

Capacity in Gallons: 1500 Material: Concrete Manufacturer: Johnson  
 Distances (in feet) of Tank to: Dwelling: 10' Private ( )/Public ( ) Water Source: 50' Property Line: \_\_\_\_\_

## ON-SITE DISPOSAL SYSTEM

Class I Systems: Standard Soil Absorption Trenches ( ) or Bed ( ) Gravelless Pipe ( ) Diameter: 10 Inches  
 Chamber Soil Absorption Trenches ( ) or Bed ( )  
 Class II Systems: Pumped/Dosed Soil Absorption Trenches ( ) or Bed ( ) Evapotranspiration Trenches ( ) or Bed ( )  
 Shallow Soil Absorption Trenches ( ) or Bed ( ) Other: \_\_\_\_\_


No. of Lines: 2 Length (in feet) of Each: 90, 80, \*see note  
 Width of Trenches: 24 inches/feet Depth to Bottom of Field: 24 inches  
 If Bed, Dimensions (in Feet): \_\_\_\_\_ If Chamber System, Name: \_\_\_\_\_, No. of Units: \_\_\_\_\_  
 Approved and Adequate Materials Used? Yes ( ) No ( ) Size Equates to: 510 Square Feet of Standard Gravel Field.  
 Distances (in feet) of System to: Dwelling: 20' Private ( )/Public ( ) Water Source: 100' Property Line: \_\_\_\_\_  
 Remarks: \* Added one 90' foot line and one 80' line to correct

An inspection indicates that the sewage disposal system described above  
**DOES MEET** ( )  
**DOES NOT MEET** ( )  
**CANNOT BE DETERMINED TO MEET** ( ) the minimum standards established by the West Virginia Bureau of Public Health.

To correct a health hazard, modifications to existing systems may be done to improve part of a system. Such modifications may not be able to be designated as a does meet system since inadequate information is known.

Although many factors contribute to the successful functioning of a sewage disposal system, this office recommends water conservation and maintaining an even usage of water throughout the week.

## Sketch of Installation with Triangulation or Distance to Specific Landmarks:

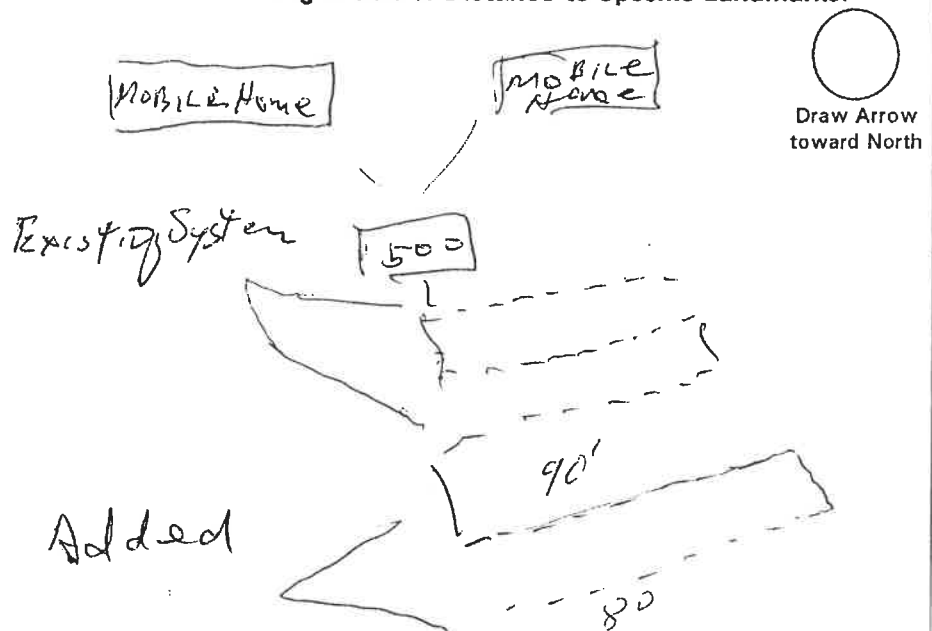Visit Date(s): 9-17-98Final Inspection Date: 11-13-98Sanitarian: [Signature]

1-177  
Revised 1-71

WEST VIRGINIA  
SEPTIC TANK INSPECTION FORM

Hampshire County Health Department Installation Permit No. ST-14-89-69

Name of Owner Mr. Brian Investments

Address Rt. 1, Box 44, Augusta, WV 26714

Property Address along U.S. 50 - Hanging Rock

DESCRIPTION & NUMBER OF UNITS SERVED

Type Facility Served 2 trailers No. Water Closets -

Lot Size 20 acres sq. ft. Area suitable for sewage disposal installation - sq. ft.

Source of Water Supply central No. Lavatories -

No. Bedrooms 5 No. Showers or Tubs - No. Baths -

No. Garbage Grinders - No. Automatic Washers -

SEPTIC TANK

Material concrete Length - x Width - x Depth - = - cubic feet

Liquid Depth - ft. Liquid Capacity 1,500 gal.

Distance to: Dwelling - Water Supply central well Nearest Property Line 100'

SOIL ABSORPTION SYSTEM

Type Drain Line Material plastic Trench Width 36 Inches

Trench Depth 20-22 Inches Total Absorption area in Trench Bottom 1020 sq. ft.

Diameter of Drain Line 4 Inches Type Filter Media #6 stone 40-60

No. of Drain Lines 5 Depth Filter Media Under Drain Line 6-10 Inches

Length of Each Line 100, 100, 30, 50, 60 ft. Depth Filter Media Over Drain Line 2 in.

Distance of Disposal Field to: (a) Dwelling 60'

(b) Water Supply 300' (c) Nearest Property Line 50'

An inspection of the septic tank system described herein disclosed that said system (MEETS, DOES NOT MEET) the minimum standards established by the West Virginia State Department of Health.

9-12-88  
Date

[Signature]  
Sanitarian

SKETCH OF SYSTEM TO BE DRAWN ON BACK

Note: Copy of this inspection report must be given to owner and the original filed in the Health Department files. PERMANENT RECORD - DO NOT DESTROY.

## SMALL SEWAGE DISPOSAL INSTALLATION PERMIT

PERMIT NO. ST-14-89-69McBride InvestmentAddress: Box 44  
Augusta WVa 26707

You are hereby issued a permit to install  
a small sewage disposal system consisting of a septic tank & drainfield  
and located at McBride Gray - across


This small sewage disposal system shall meet the following specifications:

1. Septic Tank
  - a. Shall be made of pre-cast concrete and not less than (2) 1,000.5 <sup>or 1500</sup> gallon capacity.
2. Soil-Absorption System
  - a. Shall consist of 4 distribution lines 4" in diameter.
  - b. Each distribution line shall be 85 85 85 85 feet in length
  - c. Each trench shall be 36 inch width with ZERO slope on trench bottom and ZERO slope on each distribution line.
  - d. No trench shall be more than          inches deep.
  - e. Total soil-absorption area in trench bottoms shall be 10000 sq. ft.
  - f. Filter material shall be gravel and not greater than 1/2 - 2 1/2 inches in diameter.
  - g. Filter material under each line shall be not less than 6 inches deep and not less than 2 inches over each distribution line.
  - h. Filter material shall be covered with paper prior to backfilling.
  - i. Trenches shall be backfilled at least 6" above ground surface to provide for settling of backfill.
3. Other Small Sewage or Excreta Disposal Systems (Name the type system to be used, then use back of sheet to describe the details of the system.)  
none unless noted by construction
4. Special Requirements
  - a. Small sewage and excreta disposal systems shall be located at least 10 ft. from any property line and a minimum of 20 ft. from any stream or roadside cut.
  - b. Septic tanks shall be located at least 10 ft. and excreta disposal systems a minimum of 20 ft. from building foundation.
  - c. Septic tanks shall be located a minimum of 50 ft. and soil-absorption systems and excreta disposal systems a minimum of 100 ft. from any ground water supply or cistern.
5. This permit is not transferable and automatically expires 12 months after date of issue.
6. The applicant or his agent must notify this department, phone 622-5111 at least 72 hours before the system is ready for inspection.
7. All small sewage and excreta disposal systems must be inspected and approved prior to being covered with earth or otherwise put into service. Any applicable system or part thereof covered before being inspected shall be uncovered at the direction of the SANITARIAN.
8. This permit is NULL AND VOID when official inspection reveals conditions are different than those stipulated in this permit or if facts later become known that a health hazard would result by the installation of this system.

8-2-88

Date of Issue  
Hampshire County Health Department  
66 North High Street  
Romney, West Virginia  
Health Department

David Dugger  
Name  
Sanitarian  
Title

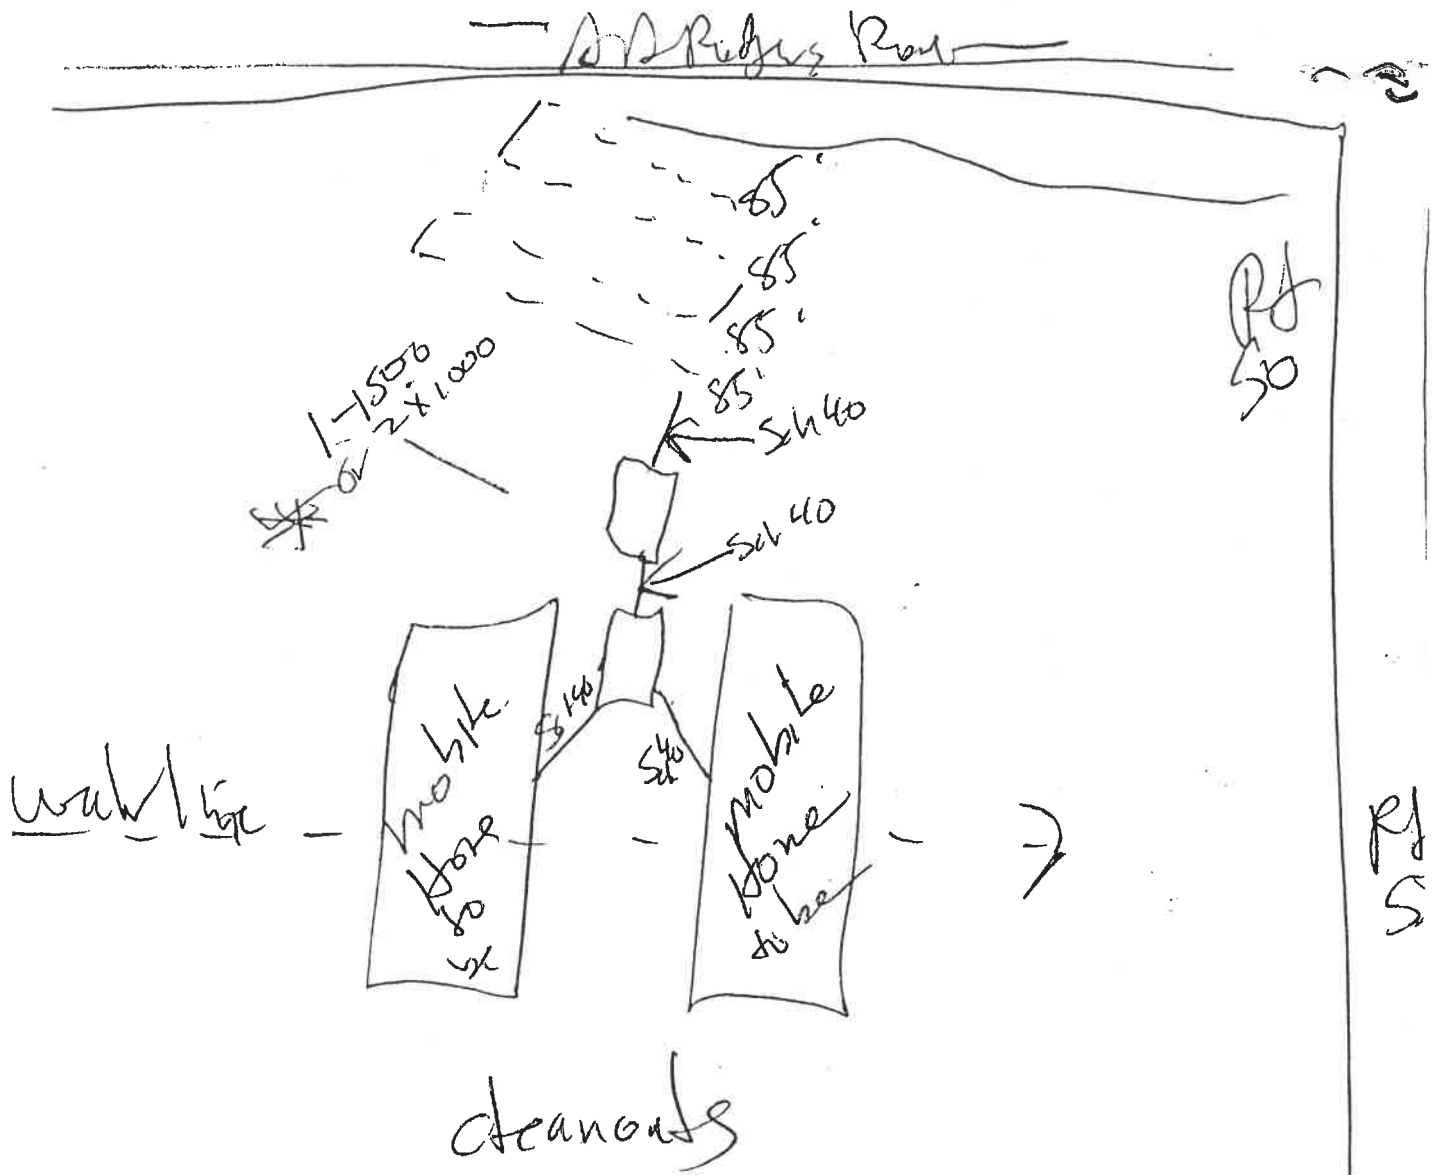

2x 1000 gallon tanks from mobile home  
Solid retention / or future pump system

David DufB  
Sanitair

**APPROVED**  
13800

AUG 20 1998

Date

Date Received 8-17-98  
Date Approved 8-20-98  
Approved by NH  
Permit Number 13800

Permit No.

ENVIRONMENTAL ENGINEERING  
W. VA. DEPARTMENT OF HEALTH

West Virginia Bureau of Public Health  
Environmental Engineering Division  
815 Quarrier Street, Suite 418  
Charleston, West Virginia 25301-2616

AUG 14 1998

## PUBLIC WATER SUPPLY SYSTEM APPLICATION FOR A PERMIT TO CONSTRUCT, ALTER, OR RENOVATE

DATE July 31, 1998

NAME OF APPLICANT McBRIDE INVESTMENTS

STREET OR PO BOX NO HC 71 Box 44

TELEPHONE NO 304-496-7342

CITY AUGUSTA

COUNTY Hampshire

ZIP CODE 26704

NAME OF ENGINEERING FIRM DRILLING CR. AS'S WELL DRILLING & PUMP CR.

STREET OR PO BOX NO POB 952

TELEPHONE NO

CITY RUMNEY

COUNTY Hampshire

ZIP CODE 26757

LOCATION OF PLANT	LOCATION OF SOURCE WATER
Latitude _____ ° _____ ' _____ "	Latitude _____ ° _____ ' _____ "
Longitude _____ ° _____ ' _____ "	Longitude _____ ° _____ ' _____ "

(If applying for water plant or water well permit)

IN ACCORDANCE WITH TITLE 64, SERIES 3, PUBLIC WATER SUPPLY REGULATIONS OF THE WEST VIRGINIA DIVISION OF HEALTH, WE HEREBY MAKE APPLICATION TO CONSTRUCT, ALTER, OR RENOVATE AS FOLLOWS:

Trailers are on individual sewage systems installed in the late 1980's. Inspected by the Hampshire Co. Health Dept.

MH

new well Existing Well (well is running dry) + Pump House

MH

MH

52' of 6 5/8" o.d. Steel Casing pressure grouted entire length

MH

MH

MH

MH

MH

MH

MH

MH

MH

MH

AA Rogers Rd

SIGNATURE OF APPLICANT OR AUTHORIZED AGENT

NOTE: A \$300 permit fee must accompany a permit application (ie: \$150 permit fee for a well application). Make check or money order payable to "West Virginia Department of Health and Human Resources." Cash not accepted. Permit applications which include both water and sewer systems need only submit a single \$300 fee.

WEST VIRGINIA  
SEPTIC TANK INSPECTION FORM


Name of Owner Ray McBride

Address Rt. 1, Box 44, Augusta, WV 26704

Property Address across from Ray's Mkt. 50 - site #1

DESCRIPTION & NUMBER OF UNITS SERVED

Type Facility Served 2 trailers No. Water Closets       

Lot Size 20 <sup>acres</sup> sq. ft. Area suitable for sewage disposal installation        sq. ft.

Source of Water Supply central No. Lavatories       

No. Bedrooms        No. Showers or Tubs        No. Baths       

No. Garbage Grinders        No. Automatic Washers       

SEPTIC TANK

Material pre-cast Length        x Width        x Depth        =        cubic feet

Liquid Depth concrete ft. Liquid Capacity 1,500 gal.

Distance to: Dwelling        Water Supply central Nearest Property Line       

SOIL ABSORPTION SYSTEM

Type Drain Line Material plastic Trench Width 36 Inches

Trench Depth 24-30 Inches Total Absorption area in Trench Bottom 1005 sq. ft.

Diameter of Drain Line 4 Inches Type Filter Media #6 coarse 40-45 tone

No. of Drain Lines 4 Depth Filter Media Under Drain Line 10 Inches

Length of Each Line 75, 75, 100, 85 ft. Depth Filter Media Over Drain Line 2 in.

Distance of Disposal Field to: (a) Dwelling       

(b) Water Supply central (c) Nearest Property Line 40'±

An inspection of the septic tank system described herein disclosed that said system (MEETS, DOES NOT MEET) the minimum standards established by the West Virginia State Department of Health.

7-78-89  
Date

[Signature]  
Sanitarian

SKETCH OF SYSTEM TO BE DRAWN ON BACK

Note: Copy of this inspection report must be given to owner and the original filed in the Health Department files. PERMANENT RECORD - DO NOT DESTROY.

182  
v. 5-82

WEST VIRGINIA  
SMALL SEWAGE OR EXCRETA DISPOSAL SYSTEM  
PERMIT APPLICATION FORM  
HEALTH DEPARTMENT

Ray McBride

304-496 NAME

PHONE

Rt. 1, Box 44

STREET/BOX NUMBER

Augusta, WY 26704

CITY/STATE/ZIP CODE

Do hereby apply for permit to ☒ Install ☐ Modify

- ☒ Septic Tank - Absorption Field  
☐ Septic Tank  
☐ Soil Absorption Field  
☐ Holding Tank

- ☐ Pit Privy  
☐ Vault Privy  
☐ Chemical or Composting Toilet  
☐ Alternate Disposal  
☐ Other (Specify) \_\_\_\_\_

To serve a:

- ☐ Residence with \_\_\_\_\_ bedrooms  
☐ Other, describe \_\_\_\_\_

Property Owned By: Above

NAME

ADDRESS

Deed Recorded In: \_\_\_\_\_

BOOK

PAGE

Hampshire  
COUNTY OF

Direction To Property \_\_\_\_\_

Work Will Be Done By: Lyle W. Daugherty

NAME

54-82-29  
INSTALLER NUMBER

Rio, WY 26755

ADDRESS

Submitted On: \_\_\_\_\_

DATE

SIGNED/OWNER

SIGNED/INSTALLER

Description of System:

Septic Tank: Capacity 1500 GAL.

Material PRE-CAST Concrete

Soil Absorption Field: Sq. Ft. \_\_\_\_\_ with \_\_\_\_\_ lines \_\_\_\_\_ long

Absorption Field Pipe ASTM Number \_\_\_\_\_

Distance Septic Tank to Nearest Water Supply \_\_\_\_\_ Nearest Property Line \_\_\_\_\_

Distance Absorption Field to Nearest Water Supply \_\_\_\_\_

Nearest Property Line \_\_\_\_\_

Alternate Type System (Attach Detailed Plans)



Description of Property:

Type of Water Supply Central Water  
Size of Lot: \_\_\_\_\_ Sq. Ft. 20 Acres  
Area Suitable for Absorption Field \_\_\_\_\_ Sq. Ft.  
Six Foot Hole Free of Water or Solid Rock: ✓ YES NO  
Percolation Test Result  
Test Hole Number One 215 Minutes  
Test Hole Number Two 150 Minutes  
Test Hole Number Three 205 Minutes  
Test Hole Number Four 185 Minutes  
TOTAL 755 Minutes






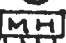

Total divided by 24 (6 inches X 4 holes) = 31 min. average  
time for water to fall (soak) one inch. Percolation test done on 7-31-87  
using approved procedures outlined in the design standards. DATE

Signed: \_\_\_\_\_

PLOT LAYOUT - SKETCH\*

Draw sketch of proposed system - show property lines, water supply and other pertinent factors.

\*Symbols

 House  
 Water Supply  
 Trees  
 Septic Tank  
--- Soil Absorption Line  
→ Direction of Ground Slope  
 Property Line  
 Percolation Test Site  
 Mobile Home

HEALTH DEPARTMENT USE

Date Application Received 6-01-89  
Date Site Evaluated 6-6-89  
Permit Number ST-14-SG-361  
Permit Denied \_\_\_\_\_  
Sanitarian D. J. [Signature]

(See Attached Letter)

PERMIT TO BE  
PRINTED OR TYPED

## STATE OF WEST VIRGINIA

Hamshire

HEALTH DEPARTMENT

Permit No.: ST-14-99-051

## ON-SITE SEWAGE DISPOSAL SYSTEM PERMIT

Tax Map \_\_\_\_\_ Parcel # \_\_\_\_\_

County Road No.: \_\_\_\_\_

Owner: Mc BRIDE Investments Certified Installer: CALVIN DAVISAddress: HC-21 BOX 44 Address: HC-28 BOX 110-D  
Augusta, WV 26204 DELRAY, WVYou are hereby issued a permit to: ☐ install, or ☒ modify an on-site sewage disposal system located:GOLDEN ACRES MOBILE HOME PARKFacility: 2 Mobile HOME Design Flow: 6 BR Lot Size: 10 Sq. Ft./Acres Water Source: wellBASED UPON REVIEW OF THE INFORMATION OF YOUR SUBMITTED APPLICATION, DATED 8-17-98, AND THE PROPER INSTALLATION OF THE HEREIN DESCRIBED SYSTEM, THE SYSTEM SHALL BE IN COMPLIANCE WITH APPLICABLE WEST VIRGINIA SEWAGE SYSTEM RULES AND DESIGN STANDARDS.

## The sewage system shall consist of a:

- ☒ Septic tank - Capacity: 1500 gallons or more, Constructed of: Concrete
- ☒ Soil disposal system with a minimum equivalency of 1800 square feet of conventional gravel trench area.

Depth to the bottom of the trench or bed installation shall be: 24-36 inches from original ground surface.☐ Gravel system: Lengths of lines: 100, 100, 100, 100, 100, 100 feet, Width: 36 inches.☐ Chamber system: Number of units: \_\_\_\_\_, Length of lines: \_\_\_\_\_, \_\_\_\_\_, \_\_\_\_\_, \_\_\_\_\_ units,

Manufacturer of chamber: \_\_\_\_\_

☐ Bed system: ☐ Gravel, ☐ Chamber; Length: \_\_\_\_\_ feet, Width: \_\_\_\_\_ feet.☒ Other: \*MAY ALSO BE 10" GRAVELLESS OR EQUIVALENT  
36" CHAMBER SYSTEM, DIVERSION WORK NEEDED

This permit is non-transferable and automatically expires 12 months after issue date.

This permit is NULL and VOID when official inspection reveals conditions different than those stipulated on the permit or facts are later found that would indicate non-compliance with applicable rules.

All systems must be inspected and approved prior to being covered with earth or placed into use.


The applicant or his agent must notify this department: 72 hours or more prior to planned inspection time.8-25-98

Issue Date

822-5711

County Office / Phone Number

Sketch of system:

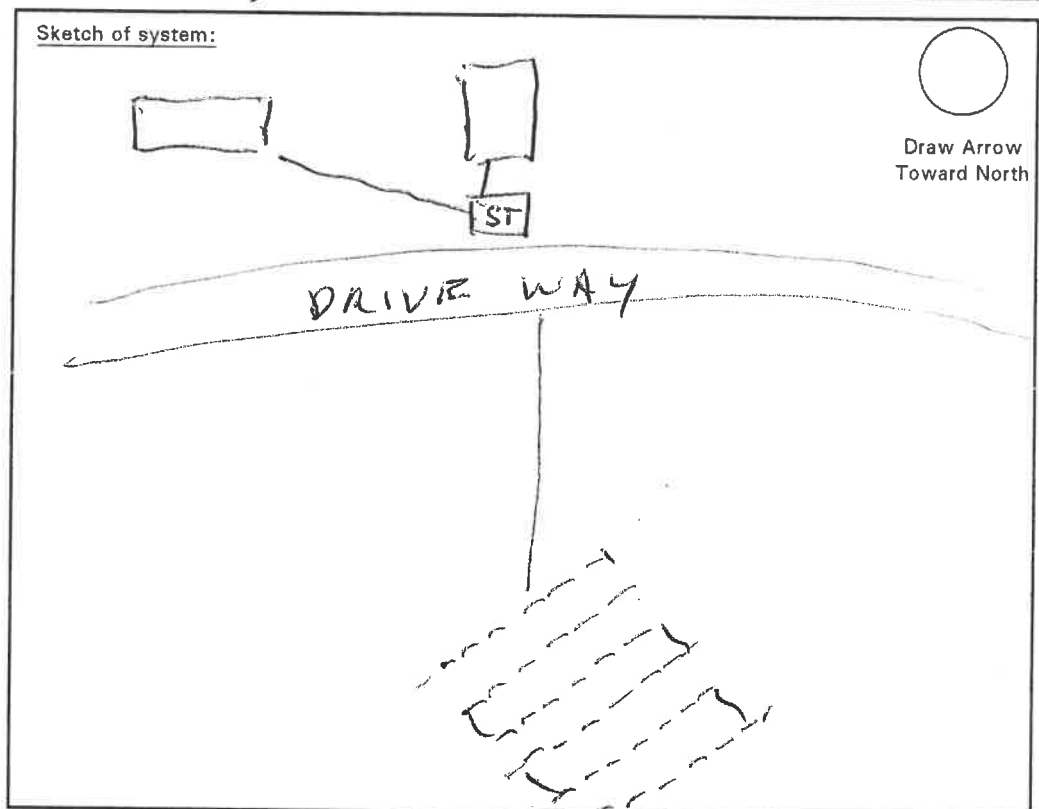Additional specifications  
on reverse:

  
Health Officer or Sanitarian

WEST VIRGINIA  
SEPTIC TANK INSPECTION FORM


Name of Owner Ray McBride

Address Rt. 1, Box 44, Augusta, WV 26704

Property Address across from Ray's mkt. 50- site # 2

DESCRIPTION & NUMBER OF UNITS SERVED

Type Facility Served 2 trailers No. Water Closets       

Lot Size 20 acres sq. ft. Area suitable for sewage disposal installation        sq. ft.

Source of Water Supply central No. Lavatories       

No. Bedrooms        No. Showers or Tubs        No. Baths       

No. Garbage Grinders        No. Automatic Washers       

SEPTIC TANK

Material pre-cast Length        x Width        x Depth        =        cubic feet

Liquid Depth concrete ft. Liquid Capacity 1,500 gal.

Distance to: Dwelling        Water Supply central Nearest Property Line       

SOIL ABSORPTION SYSTEM

Type Drain Line Material plastic Trench Width 36 Inches

Trench Depth 24-30 Inches Total Absorption area in Trench Bottom 1020 sq. ft.

Diameter of Drain Line 4 Inches Type Filter Media #6 stone - 40-45 tons

No. of Drain Lines 4 Depth Filter Media Under Drain Line 10 Inches

Length of Each Line 75, 90, 100, 25 ft. Depth Filter Media Over Drain Line 2 in.

Distance of Disposal Field to: (a) Dwelling       

(b) Water Supply central (c) Nearest Property Line       

An inspection of the septic tank system described herein disclosed that said system (MEETS, DOES NOT MEET) the minimum standards established by the West Virginia State Department of Health.

7-28-89  
Date

[Signature]  
Sanitarian

SKETCH OF SYSTEM TO BE DRAWN ON BACK

Note: Copy of this inspection report must be given to owner and the original filed in the Health Department files. PERMANENT RECORD - DO NOT DESTROY.

WEST VIRGINIA  
SMALL SEWAGE OR EXCRETA DISPOSAL SYSTEM  
PERMIT APPLICATION FORM  
HEALTH DEPARTMENT

Ray McBride

304 - 496  
NAME

PHONE

Rt. 1 Box 44  
STREET/BOX NUMBER  
Augusta, WV 26704

CITY/STATE/ZIP CODE

Do hereby apply for permit to ☒ Install ☐ Modify

- ☒ Septic Tank - Absorption Field  
☐ Septic Tank  
☐ Soil Absorption Field  
☐ Holding Tank

- ☐ Pit Privy  
☐ Vault Privy  
☐ Chemical or Composting Toilet  
☐ Alternate Disposal  
☐ Other (Specify) \_\_\_\_\_

To serve a:

- ☐ Residence with \_\_\_\_\_ bedrooms  
☐ Other, describe \_\_\_\_\_

Property Owned By: Above  
NAME

ADDRESS

Deed Recorded In: \_\_\_\_\_  
BOOK PAGE

Hampshire  
COUNTY OF

Direction To Property \_\_\_\_\_

Work Will Be Done By: Lyle W. Daugherty  
NAME

54-82-29  
INSTALLER NUMBER

Rt. 1, WV 26755  
ADDRESS

Submitted On: \_\_\_\_\_  
DATE

SIGNED/OWNER

SIGNED/INSTALLER

Description of System:

Septic Tank: Capacity 1500 GAL. Material Pre-cast concrete  
Soil Absorption Field: Sq. Ft. 1000 with 1 lines 10 long  
Absorption Field Pipe ASTM Number \_\_\_\_\_  
Distance Septic Tank to Nearest Water Supply \_\_\_\_\_ Nearest Property Line \_\_\_\_\_  
Distance Absorption Field to Nearest Water Supply \_\_\_\_\_  
Nearest Property Line \_\_\_\_\_

Alternate Type System (Attach Detailed Plans)

WEST VIRGINIA  
SEPTIC TANK INSPECTION FORM


Name of Owner McBride Investments

Address 411 Box 44, Augusta, WV 26704

Property Address across from McBride Store

DESCRIPTION & NUMBER OF UNITS SERVED

Type Facility Served 2 trailers No. Water Closets \_\_\_\_\_

Lot Size 20 acres sq. ft. Area suitable for sewage disposal installation \_\_\_\_\_ sq. ft.

Source of Water Supply central No. Lavatories \_\_\_\_\_

No. Bedrooms 5 No. Showers or Tubs \_\_\_\_\_ No. Baths \_\_\_\_\_

No. Garbage Grinders \_\_\_\_\_ No. Automatic Washers \_\_\_\_\_

SEPTIC TANK

Material concrete Length \_\_\_\_\_ x Width \_\_\_\_\_ x Depth \_\_\_\_\_ = \_\_\_\_\_ cubic feet

Liquid Depth \_\_\_\_\_ ft. Liquid Capacity 1000 gal.

Distance to: Dwelling 60'± Water Supply 250'± Nearest Property Line 250'±

SOIL ABSORPTION SYSTEM

Type Drain Line Material plastic Trench Width 36 Inches

Trench Depth 24 Inches Total Absorption area in Trench Bottom 1005 sq. ft.

Diameter of Drain Line 4 Inches Type Filter Media #6 stone - 42 ton

No. of Drain Lines 4 Depth Filter Media Under Drain Line 6-10 Inches

Length of Each Line 35, 100, 100, 100 ft. Depth Filter Media Over Drain Line 2 in.

Distance of Disposal Field to: (a) Dwelling 20'±

(b) Water Supply 250'± (c) Nearest Property Line 250'±

An inspection of the septic tank system described herein disclosed that said system (MEETS, DOES NOT MEET) the minimum standards established by the West Virginia State Department of Health.

10-12-58  
Date

[Signature]  
Sanitarian

SKETCH OF SYSTEM TO BE DRAWN ON BACK

Note: Copy of this inspection report must be given to owner and the original filed in the Health Department files. PERMANENT RECORD - DO NOT DESTROY.

Description of Property:

Type of Water Supply Central Well approx 200+ ft.  
 Size of Lot: Sq. Ft. 20,478 Acres  
 Area Suitable for Absorption Field Sq. Ft.  
 Six Foot Hole Free of Water or Solid Rock: YES NO

Percolation Test Result


Test Hole Number One	<u>105</u>	Minutes
Test Hole Number Two	<u>90</u>	Minutes
Test Hole Number Three	<u>95</u>	Minutes
Test Hole Number Four	<u>120</u>	Minutes
TOTAL	<u>410</u>	Minutes

Total divided by 24 (6 inches X 4 holes) = 17 min. average  
 time for water to fall (soak) one inch. Percolation test done on 9-5-88  
 using approved procedures outlined in the design standards. DATE

Signed: Lee W. Daugherty

PLOT LAYOUT - SKETCH\*

Draw sketch of proposed system - show property lines, water supply and other pertinent factors. North River

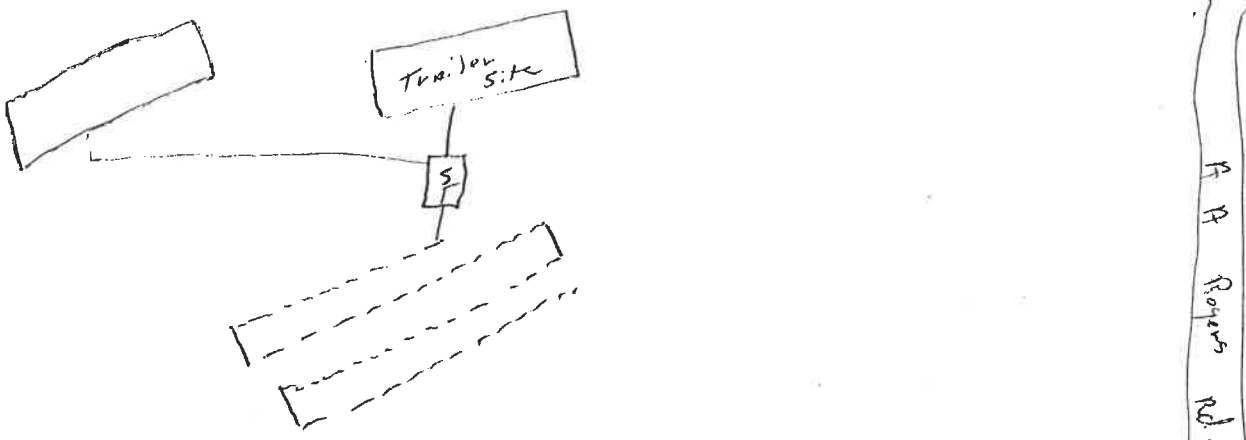

\*Symbols



House



Water Supply



Trees



Septic Tank

--- Soil Absorption Line

→ Direction of Ground Slope



Property Line

Percolation Test Site

Mobile Home

HEALTH DEPARTMENT USE

Date Application Received 9-12-88  
 Date Site Evaluated 9-13-88  
 Permit Number ST-14-88-120  
 Permit Denied Dunlop  
 Sanitarian Dunlop

(See Attached Letter)

82  
J. 5-82

WEST VIRGINIA  
SMALL SEWAGE OR EXCRETA DISPOSAL SYSTEM  
PERMIT APPLICATION FORM  
HEALTH DEPARTMENT

Mc Bride Investments INC  
NAME

RT 1 Box 44  
STREET/BOX NUMBER

496- 7342  
PHONE

Augusta W. Va. 26704  
CITY/STATE/ZIP CODE

Do hereby apply for permit to ✓ Install          Modify         

- ☒ Septic Tank - Absorption Field  
☐ Septic Tank  
☐ Soil Absorption Field  
☐ Holding Tank

- ☐ Pit Privy  
☐ Vault Privy  
☐ Chemical or Composting Toilet  
☐ Alternate Disposal  
☐ Other (Specify)

To serve a:

- ☐ Residence with 4 bedrooms  
☐ Other, describe 2 Trailers

Property Owned By: Above  
NAME ADDRESS

Deed Recorded In: 219 729 Hampshire  
BOOK PAGE COUNTY OF

Direction To Property Along U.S. 50 @ Hanging Rock

Work Will Be Done By: Lyle W. Daugherty 54-82-27  
NAME INSTALLER NUMBER

Rt. 1, W. Va. 26755  
ADDRESS

Submitted On: 9-5-88 Ray Mc Bride Lyle W. Daugherty  
DATE SIGNED/OWNER SIGNED/INSTALLER

Description of System:

Septic Tank: Capacity 1500 gal Material Precast Concrete  
Soil Absorption Field: Sq. Ft. 1000 with 4 lines 85 ft long  
Absorption Field Pipe ASTM Number 2729  
Distance Septic Tank to Nearest Water Supply 200 ft Nearest Property Line 100 ft  
Distance Absorption Field to Nearest Water Supply 200 ft  
Nearest Property Line 100 ft

Alternate Type System (Attach Detailed Plans)

WEST VIRGINIA  
SEPTIC TANK INSPECTION FORM

Hampshire County Health Department Installation Permit No. ST-14-91-115  
Name of Owner Ray McBride  
Address Rt. 1 Box 44 Augusta WV 26704  
Property Address same

DESCRIPTION & NUMBER OF UNITS SERVED

Type Facility Served 2 trailers No. Water Closets \_\_\_\_\_  
Lot Size 20 <sup>acres</sup> sq. ft. Area suitable for sewage disposal installation \_\_\_\_\_ sq. ft.  
Source of Water Supply central No. Lavatories \_\_\_\_\_  
No. Bedrooms 4 No. Showers or Tubs \_\_\_\_\_ No. Baths \_\_\_\_\_  
No. Garbage Grinders \_\_\_\_\_ No. Automatic Washers \_\_\_\_\_

SEPTIC TANK

Material precast concrete Length \_\_\_\_\_ x Width \_\_\_\_\_ x Depth \_\_\_\_\_ = \_\_\_\_\_ cubic feet  
Liquid Depth \_\_\_\_\_ ft. Liquid Capacity 1500 gal.  
Distance to: Dwelling \_\_\_\_\_ Water Supply \_\_\_\_\_ Nearest Property Line \_\_\_\_\_

SOIL ABSORPTION SYSTEM

Type Drain Line Material plastic Trench Width 36 Inches  
Trench Depth 22-24 Inches Total Absorption area in Trench Bottom 1035 sq. ft.  
Diameter of Drain Line 4 Inches Type Filter Media #6 stone - 45 ton  
No. of Drain Lines 4 Depth Filter Media Under Drain Line 6-8 Inches  
Length of Each Line 85, 85, 90, 85 ft. Depth Filter Media Over Drain Line 2 in  
Distance of Disposal Field to: (a) Dwelling 160'  
(b) Water Supply 200'± (c) Nearest Property Line 300'±

An inspection of the septic tank system described herein disclosed that said system (MEETS, DOES NOT MEET) the minimum standards established by the West Virginia State Department of Health.

Date 8/24/90

[Signature]  
Sanitarian

SKETCH OF SYSTEM TO BE DRAWN ON BACK

Note: Copy of this inspection report must be given to owner and the original filed in the Health Department files. PERMANENT RECORD - DO NOT DESTROY.



Option of Property:

Type of Water Supply Drilled Well (central water supply)  
Size of Lot: \_\_\_\_\_ Sq. Ft. 20 Acres  
Area Suitable for Absorption Field \_\_\_\_\_ Sq. Ft.  
Six Foot Hole Free of Water or Solid Rock: ✓ YES     NO  
Percolation Test Result


Test Hole Number One	<u>100</u>	Minutes
Test Hole Number Two	<u>50</u>	Minutes
Test Hole Number Three	<u>110</u>	Minutes
Test Hole Number Four	<u>100</u>	Minutes
TOTAL	<u>360</u>	Minutes

Total divided by 24 (6 inches X 4 holes) = 15 min. average  
time for water to fall (soak) one inch. Percolation test done on 7-31-90  
using approved procedures outlined in the design standards. DATE

Signed: Lyle W. Daugherty

PLOT LAYOUT - SKETCH\*

Draw sketch of proposed system - show property lines, water supply and other pertinent factors.

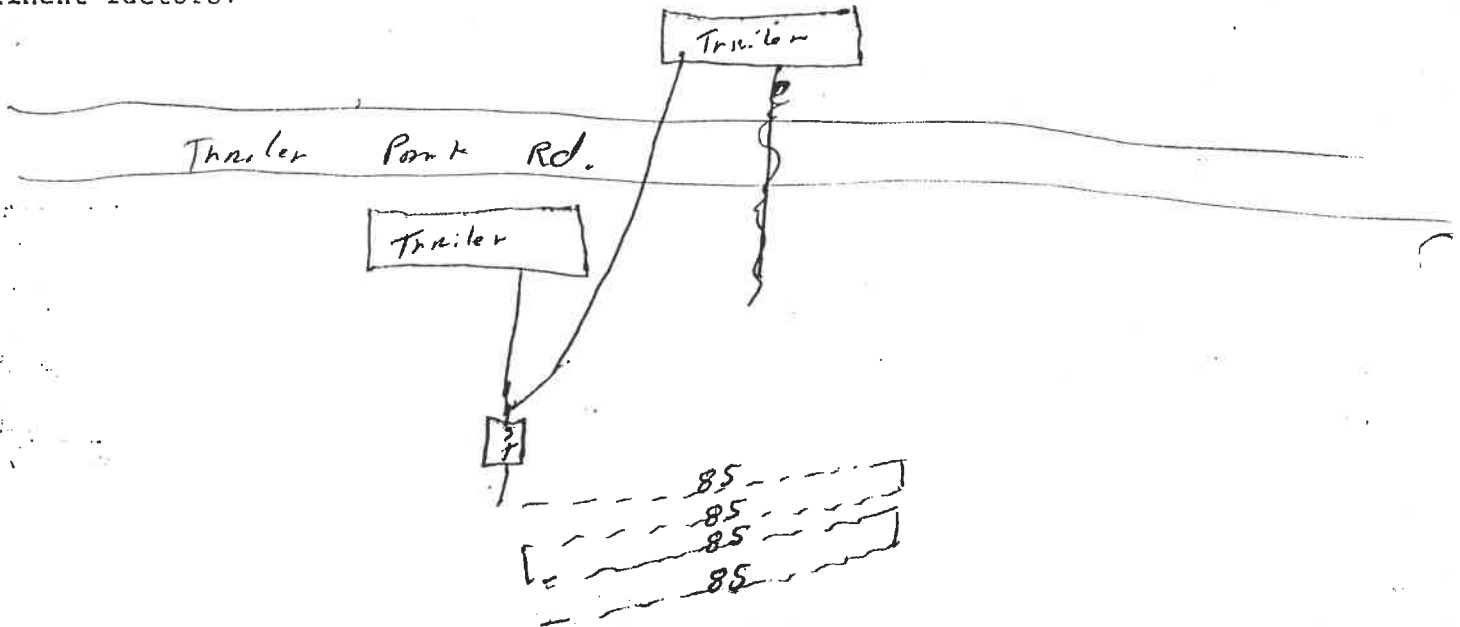

\*Symbols



House



Septic Tank

--- Soil Absorption Line

→ Direction of Ground Slope



Property Line



Percolation Test Site



Mobile Home

HEALTH DEPARTMENT USE

Date Application Received 7-31-90  
Date Site Evaluated 8-7-90  
Permit Number SA-14-91-113  
Permit Denied \_\_\_\_\_  
Sanitarian Duffy

(See Attached Letter)

WEST VIRGINIA  
SMALL SEWAGE OR EXCRETA DISPOSAL SYSTEM  
PERMIT APPLICATION FORM  
Hampshire HEALTH DEPARTMENT

Ray McBride  
NAME

                      
PHONE

Rt 1 Box 44  
STREET/BOX NUMBER

Augusta W.Va. 26704  
CITY/STATE/ZIP CODE

Do hereby apply for permit to ✓ Install                      Modify                     

- (✓) Septic Tank -- Absorption Field  
( ) Septic Tank  
( ) Soil Absorption Field  
( ) Holding Tank

- ( ) Pit Privy  
( ) Vault Privy  
( ) Chemical or Composting Toilet  
( ) Alternate Disposal  
( ) Other (Specify)

To serve a (2) Trailers

- ( ) Residence with 4 bedrooms  
( ) Other, describe Golden Acres Trailer Park

Property Owned By: Above  
NAME ADDRESS

Deed Recorded In:                      BOOK                      PAGE Hampshire  
COUNTY OF

Direction To Property                     

Work Will Be Done By: Lyle W. Daugherty  
NAME INSTALLER NUMBER 54-82-29

Rt 1 W.Va. 26755  
ADDRESS

Submitted On: 5/14/90  
DATE

[Signature]  
SIGNED/OWNER

Lyle W. Daugherty  
SIGNED/INSTALLER

Description of System:

Septic Tank: Capacity 1500 Material Pre-Cast Concrete  
Soil Absorption Field: Sq. Ft. 1020 with 4 lines 85 ft. long  
Absorption Field Pipe ASTM Number 2727  
Distance Septic Tank to Nearest Water Supply 200 ft Nearest Property Line 350 ft  
Distance Absorption Field to Nearest Water Supply 200 ft  
Nearest Property Line 350 ft

Alternate Type System (Attach Detailed Plans)