
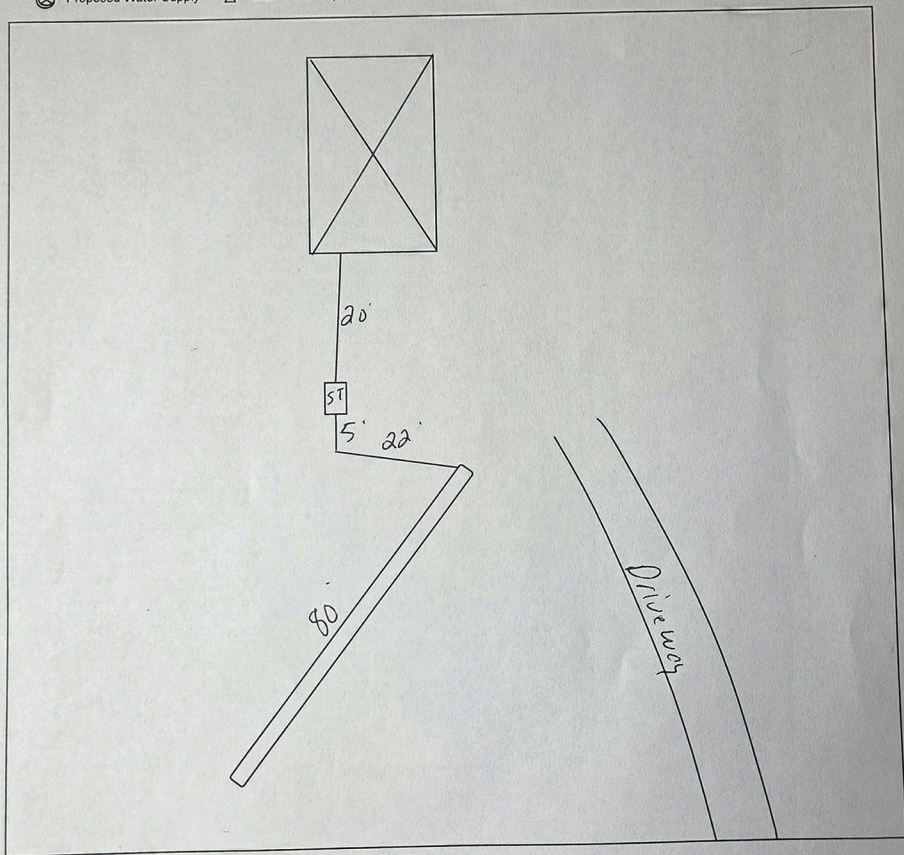
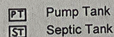
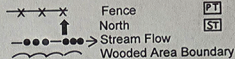
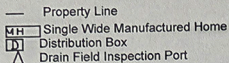


Sketch of Installation with Triangulation or Distance to Specific Landmarks. Include reserve area boundaries.

LEGEND:

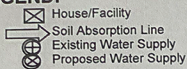

System is: Approved ☒ System is NOT Approved: ☐

COMMENTS: _____

Date of Final 3/5/2025 _____

[Signature]
Sanitarian

4/2/2025
Date Final Issued