SS-177
Revised 1-71

WEST VIRGINIA
SEPTIC TANK INSPECTION FORM

HARDY CO Health Department Installation Permit No. ST1695097

Name of Owner HAZEL SHUMAN

Address 1224 STEELTON AVE, BALTIMORE, MD 21224

Property Address LOT 11, SECTION 1, LOST RIVER RIDGE, WARDENSVILLE, WV

DESCRIPTION & NUMBER OF UNITS SERVED

Type Facility Served HOME No. Water Closets _____

Lot Size 6+ ACRES ~~sq. ft.~~ Area suitable for sewage disposal installation _____ sq.ft.

Source of Water Supply DRILLED WELL No. Lavatories _____

No. Bedrooms 4 No. Showers or Tubs _____ No. Baths _____

No. Garbage Grinders _____ No. Automatic Washers _____

SEPTIC TANK

Material CONCRETE Length _____ x Width _____ x Depth _____ = _____ cubic feet

Liquid Depth _____ ft. Liquid Capacity _____ gal.

Distance to: Dwelling >25' Water Supply ≥165' Nearest Property Line >10'

SOIL ABSORPTION SYSTEM

Type Drain Line Material PLASTIC Trench Width 36 Inches

Trench Depth 20-36 Inches Total Absorption area in Trench Bottom 1140 sq. ft.

Diameter of Drain Line 4 Inches Type Filter Media GRAVEL

No. of Drain Lines 4 Depth Filter Media Under Drain Line 6 Inches

Length of Each Line 84, 96, 100, 100 ft. Depth Filter Media Over Drain Line 2 in.

Distance of Disposal Field to: (a) Dwelling >35'

(b) Water Supply ≥178' (c) Nearest Property Line >10'

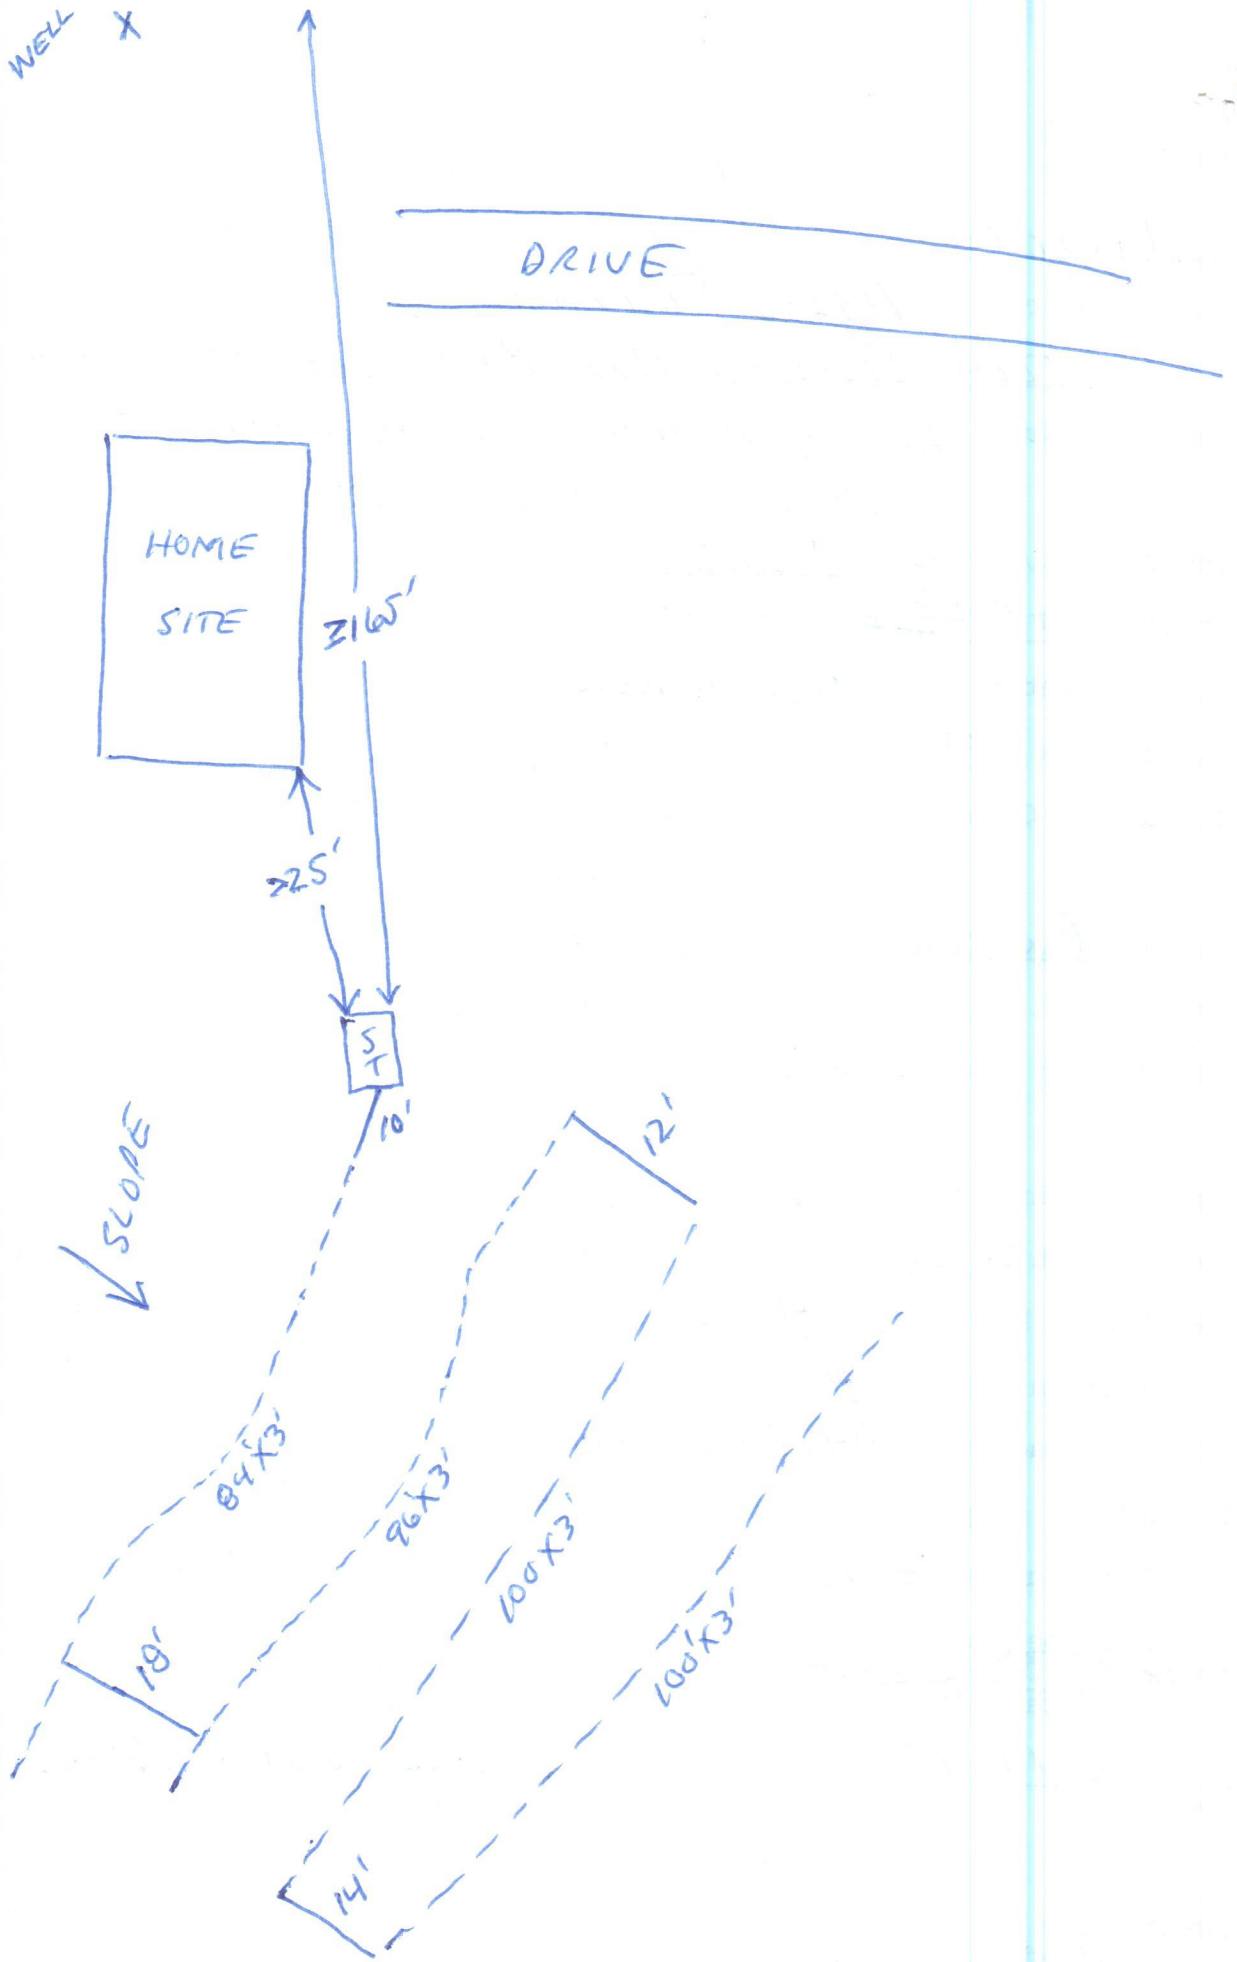
An inspection of the septic tank system described herein disclosed that said system (MEETS, ~~DOES NOT MEET~~) the minimum standards established by the West Virginia State Department of Health.

8-14-95
Date

Lenore K. Thompson, R.S.
Sanitarian

SKETCH OF SYSTEM TO BE DRAWN ON BACK

Note: Copy of this inspection report must be given to owner and the original filed in the Health Department files. PERMANENT RECORD - DO NOT DESTROY.


WELL
DRIVE
HOME SITE
ST
10'
SLOPE
84'X3'
96'X3'
100'X3'
100'X3'
18'
12'
14'

WV STATE DEPARTMENT OF HEALTH
Office of Environmental Health Services
ENVIRONMENTAL ENGINEERING DIVISION

WELL COMPLETION REPORT

Date(s) 6-8-95 - 6-7-96 County Hardy Permit #: DW1695042

Town: Baker Area Name/Location East Rim Ridge

Well Owner: Hazel Shuman Address: 1224 Stenton Ave

Telephone Number: 410-633-3169 Balt Md 21224

Well Driller: Roger DeHaven Address: 4506-1 N. Frederick Pike

Telephone Number: 703-888-3800 Winchester Va 22603

WELL LOG

DEPTH IN FEET	FORMATIONS: KIND, THICKNESS, AND IF WATER BEARING
0-135	Clay + Yellow Slate.
135-300	Blue Slate.
265-266	5 GPM

REMARKS:

Type of Well: Water Drilling Method: Air Hammer.

Well Diameter: 6 3/8 Casing O.D.: 6 5/8

Well Depth: 300' Date Completed: 7/25/95

CASING: Length 140 Feet Height above ground 1 Feet

☑ Steel ☐ Plastic ☐ Cast Iron

Other _____ Type

SCREEN

☑ None Installed

Type _____ Diameter _____

Slot/Gauge _____ Length _____

Set Between _____ Ft. and _____ Ft.

PUMPING OR BAILING TEST

DETAILS	#1	#2	#3
Static Water Level (Ft. Below Grade)			
Pumping Rate (GPM)	[redacted]	5	
Pumping Level (Ft Below Grade)			
Duration of Test (In Hours)			
Recovery Time to Static Level (In Hours)			

WELL HEAD

Pitless Adapter: Type, Make, Etc. _____

Well Cap: Type, Make, Etc. _____

Well Seal: Type, Make, Etc. _____

Well Platform:

Length _____ Width _____ Thickness _____

Grouting: [redacted] ☑ No

All Public Water Supplies must be grouted.

I hereby certify that this well was drilled and constructed under my supervision, in compliance with all requirements of the referenced permit, and that this record is true to the best of my knowledge and belief.

Roger T DeHaven 021
Name Certification No.

Roger T DeHaven Well Drilling Inc
Registered Business Name

Roger T DeHaven 7-31-95
Signed Date